USE TYPEWRITER OR BALL POINT PEN-PRESS FIRMLY, PRINT CLEARLY.

#33L

# WATER WELL RECORD
KSA 82a-1201-1215

Kansas Department of Health and Environment-Division of Environment
(Water well Contractors)
Topeka, Kansas 66620

| 1. Location of well: | County | Fraction | Section number | Township number | Range number |
|---|---|---|---|---|---|
| | Morris | NW 1/4 SE 1/4 SE 1/4 | 27 | T 15 S | R 8 (E) W |

2. Distance and direction from nearest town or city: 4 Mile North of Council Grove
Street address of well location if in city:

3. Owner of well: Richard SAIZ
R.R. or street: Box 54
City, state, zip code: Council Grove, Ks

4. Locate with "X" in section below:

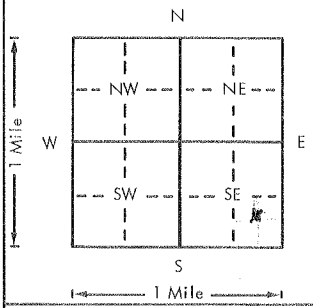


Sketch map:

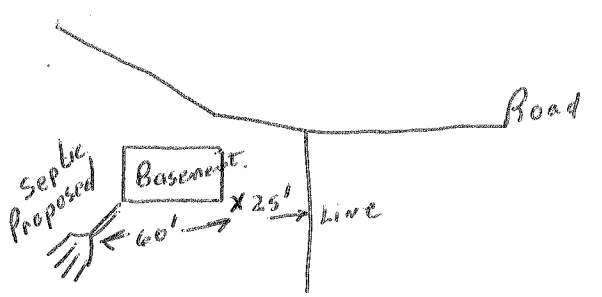


6. Bore hole dia. 6 3/4 in. Completion date 3-13-79
Well depth X 80 ft.

7. ___ Cable tool X Rotary ___ Driven ___ Dug
___ Hollow rod ___ Jetted ___ Bored ___ Reverse rotary

8. Use: X Domestic ___ Public supply ___ Industry
___ Irrigation ___ Air conditioning ___ Stock
___ Lawn ___ Oil field water ___ Other

9. Casing: Material Plts Height: (Above) or below
Threaded ___ Welded glw Surface 16 in.
RMP X PVC ___ Weight ___ lbs./ft.
Dia. 5 in. to 50 ft. depth Wall Thickness: inches or
Dia. ___ in. to ___ ft. depth gage No. 1200

| 5. Type and color of material | From | To |
|---|---|---|
| Topsoil - Blk | 0 | 3 |
| Shale - Green | 3 | 9 |
| Lime - TAN | 9 | 24 23 |
| Shale - Dk Gray | 24 23 | 26 |
| Lime & Flint Strips - Gray Some Shale Breaks | 26 | 64 |
| Shale - Green & Red | 64 | 68 |
| Lime - Gray | 68 | 69 |
| Shale - Red & Green | 69 | 76 |
| Lime - Dk Gray | 76 | 80 |
| | | |
| | | |
| | | |
| | | |
| | | |
| | | |
| (Use a second sheet if needed) | | |

10. Screen: Manufacturer's name Jess & Lowell
Type RMP Dia. 5"
Slot/gauze Yo Length 30
Set between 50 ft. and 80 ft.
___ ft. and ___ ft.
Gravel pack? NO Size range of material ___

11. Static water level: mo./day/yr.
50 ft. below land surface Date 3-13-79

12. Pumping level below land surfaces:
___ ft. after ___ hrs. pumping ___ g.p.m.
___ ft. after ___ hrs. pumping ___ g.p.m.
Estimated maximum yield 12 g.p.m.

13. Water sample submitted: mo./day/yr.
___ Yes X No Date ___

14. Well head completion:
___ Pitless adapter 16 Inches above grade

15. Well grouted? Yes
With: X Neat cement ___ Bentonite ___ Concrete
Depth: From X 3 ft. to X 13 ft.

16. Nearest source of possible contamination:
ft. 60 Direction E.S.E. Type Septic
Well disinfected upon completion? X Yes ___ No

17. Pump: X Not installed
Manufacturer's name ___
Model number ___ HP ___ Volts ___
Length of drop pipe ___ ft. capacity ___ g.p.m.
Type:
___ Submersible ___ Turbine
___ Jet ___ Reciprocating
___ Centrifugal ___ Other

18. Elevation:

Topography:
___ Hill
X Slope
___ Upland
___ Valley

19. Remarks: Concrete slab around well is responsibility of Customer

20. Water well contractor's certification:
This well was drilled under my jurisdiction and this report is true to the best of my knowledge and belief.
Zinn Water Well Drlg 218
Business name License No.
Address Lost Springs, KS
Signed Joseph A. Zinn Date 3-19-79
Authorized representative

T 15 S R 8 W Sec 27 1/4 1/4 1/4 SE

Forward the white, blue and pink copies to the Department of Health and Environment

Form WWC-5

MI-1023