

WATER WELL RECORD Form WWC-5

Corrected Copy


Original Record Correction Change in Well Use

Division of Water Resources App. No.

Well ID

1 LOCATION OF WATER WELL: County: Morris Fraction SW 1/4 NW 1/4 SE 1/4 Section Number 21 Township Number T 15 S Range Number R 8 E W

2 WELL OWNER: Last Name: amos First: max Street or Rural Address where well is located: 1059 S 1050 RD, COUNCIL GROOVE KS

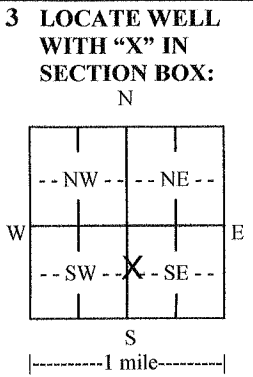

3 LOCATE WELL WITH 'X' IN SECTION BOX: N S W E
4 DEPTH OF COMPLETED WELL: 65 ft. Depth(s) Groundwater Encountered: 1) 47 ft. 2) ... 3) ... 4) Dry Well
WELL'S STATIC WATER LEVEL: 38 ft. below land surface, measured on (mo-day-yr) 4/1/2014

5 Latitude: 38.7288166 Longitude: 96.5288 Datum: WGS 84 NAD 83 NAD 27 Source for Latitude/Longitude: GPS Land Survey Topographic Map Online Mapper
6 Elevation: 1376 ft. Ground Level TOC Source: Land Survey GPS Topographic Map Other KOLAR

7 WELL WATER TO BE USED AS: 1. Domestic: Household Lawn & Garden Livestock 2. Irrigation 3. Feedlot 4. Industrial 5. Public Water Supply: well ID 6. Dewatering: how many wells? 7. Aquifer Recharge: well ID 8. Monitoring: well ID 9. Environmental Remediation: well ID Air Sparge Soil Vapor Extraction Recovery Injection 10. Oil Field Water Supply: lease 11. Test Hole: well ID Cased Uncased Geotechnical 12. Geothermal: how many bores? a) Closed Loop Horizontal Vertical b) Open Loop Surface Discharge Inj. of Water 13. Other (specify):

Was a chemical/bacteriological sample submitted to KDHE? Yes No If yes, date sample was submitted:
Water well disinfected? Yes No

8 TYPE OF CASING USED: Steel PVC Other CASING JOINTS: Glued Clamped Welded Threaded
Casing diameter 5 in. to 65 ft., Diameter 18 in. to ... ft., Diameter ... in. to ... ft.
Casing height above land surface 18 in. Weight ... lbs./ft. Wall thickness or gauge No. 214
TYPE OF SCREEN OR PERFORATION MATERIAL: Steel Stainless Steel Fiberglass PVC Other (Specify)
SCREEN OR PERFORATION OPENINGS ARE: Continuous Slot Mill Slot Gauze Wrapped Torch Cut Drilled Holes Other (Specify)
Louvered Shutter Key Punched Wire Wrapped Saw Cut None (Open Hole)
SCREEN-PERFORATED INTERVALS: From 40 ft. to 65 ft., From ... ft. to ... ft., From ... ft. to ... ft.
GRAVEL PACK INTERVALS: From 64 ft. to 65 ft., From ... ft. to ... ft., From ... ft. to ... ft.

9 GROUT MATERIAL: Neat cement Cement grout Bentonite Other
Grout Intervals: From 3 ft. to 24 ft., From ... ft. to ... ft., From ... ft. to ... ft.
Nearest source of possible contamination: Septic Tank Lateral Lines Pit Privy Livestock Pens Insecticide Storage
Sewer Lines Cess Pool Sewage Lagoon Fuel Storage Abandoned Water Well
Watertight Sewer Lines Seepage Pit Feedyard Fertilizer Storage Oil Well/Gas Well
Other (Specify)
Direction from well? E Distance from well? 60 ft.

Table with 6 columns: FROM, TO, LITHOLOGIC LOG, FROM, TO, LITHO. LOG (cont.) or PLUGGING INTERVALS. Rows include TOP SOIL, CLAY BRN, LIME & FLINT, SHALE GRAY, LIME, SHALE RED, FRACTURED LIMW, SHALE GRAY, FRAC LIME TAN. Includes a 'Notes' section with handwritten text 'with month'.

11 CONTRACTOR'S OR LANDOWNER'S CERTIFICATION: This water well was constructed, reconstructed, or plugged under my jurisdiction and was completed on (mo-day-year) 3/1/2014 and this record is true to the best of my knowledge and belief. Kansas Water Well Contractor's License No. 218 This Water Well Record was completed on (mo-day-year) 3/25/2014 under the business name of Zinn Water Well Drig.