

**CORRECTION(S) TO WATER WELL RECORD (WWC-5)**

(to rectify lacking or incorrect information)

County: Wabaunsee

**Location listed as:**

Section-Township-Range: 2-17S-9E

Fraction (  $\frac{1}{4}$   $\frac{1}{4}$   $\frac{1}{4}$ ): SE SW SE

**Location changed to:**

2-15S-9E

SE SW SE

**Other changes:** Initial statements: \_\_\_\_\_

Changed to: \_\_\_\_\_

Comments: \_\_\_\_\_

verification method: Phone call to well contractor, and mapping tool  
on KGS website.

initials: ORL date: 3/31/2006

submitted by: Kansas Geological Survey, Data Resources Library, 1930 Constant Ave., Lawrence, KS 66047-3726  
to: Kansas Dept of Health & Environment, Bureau of Water, 1000 SW Jackson, Suite 420, Topeka, KS 66612-1367.

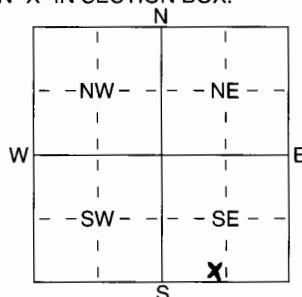
1 LOCATION OF WATER WELL:	Fraction	Section Number	Township Number	Range Number
County: <u>Wabawsee</u>	<u>SE 1/4 SW 1/4 SE 1/4</u>	<u>2</u>	T <u>17</u> S	R <u>9</u> <u>EW</u>

Distance and direction from nearest town or city street address of well if located within city?

10 mile NE of Council Grove2 WATER WELL OWNER: Charles SammersRR#, St. Address, Box # : 925 E Main  
City, State, ZIP Code : Council Grove, KS 66846Board of Agriculture, Division of Water Resources  
Application Number:

3 LOCATE WELL'S LOCATION WITH 4 DEPTH OF COMPLETED WELL ..... ft. ELEVATION: .....

AN "X" IN SECTION BOX:

Depth(s) Groundwater Encountered 1 64 ft. 2 ..... ft. 3 ..... ft.  
WELL'S STATIC WATER LEVEL ..... 6.0 ft. below land surface measured on mo/day/yr Feb 22-06Pump test data: Well water was ..... ft. after ..... hours pumping ..... gpm  
Est. Yield ..... 5 gpm: Well water was ..... ft. after ..... hours pumping ..... gpmWELL WATER TO BE USED AS:  
1 Domestic 3 Feedlot 5 Public water supply 8 Air conditioning 11 Injection well  
2 Irrigation 4 Industrial 6 Oil field water supply 9 Dewatering 12 Other (Specify below)  
7 Domestic (lawn & garden) 10 Monitoring wellWas a chemical/bacteriological sample submitted to Department? Yes ..... No X ..... If yes, mo/day/yr sample was submitted  
Water Well Disinfected Yes No

5 TYPE OF BLANK CASING USED:

1 Steel 3 RMP (SR) 5 Wrought iron 8 Concrete tile  
2 PVC 4 ABS 6 Asbestos-Cement 9 Other (specify below)CASING JOINTS: Glued X Clamped .....  
Welded .....  
Threaded .....Blank casing diameter ..... 5 in. to ..... 6.0 ft., Dia ..... in. to ..... ft., Dia ..... in. to ..... ft.Casing height above land surface ..... in., weight ..... lbs./ft. Wall thickness or gauge No. SDA-26

TYPE OF SCREEN OR PERFORATION MATERIAL:

1 Steel 3 Stainless Steel 5 Fiberglass 7 PVC  
2 Brass 4 Galvanized Steel 6 Concrete tile 8 RMP (SR)  
9 ABS10 Asbestos-Cement  
11 Other (Specify) .....  
12 None used (open hole)

SCREEN OR PERFORATION OPENINGS ARE:

1 Continuous slot 3 Mill slot  
2 Louvered shutter 4 Key punched5 Gauzed wrapped 8 Saw cut 11 None (open hole)  
6 Wire wrapped 9 Drilled holes  
7 Torch cut 10 Other (specify) .....SCREEN-PERFORATED INTERVALS: From ..... 6.0 ft. to ..... 8.5 ft., From ..... ft. to ..... ft.

From ..... ft. to ..... ft., From ..... ft. to ..... ft.

GRAVEL PACK INTERVALS: From ..... None ft. to ..... ft., From ..... ft. to ..... ft.

From ..... ft. to ..... ft., From ..... ft. to ..... ft.

6 GROUT MATERIAL: 1 Neat cement 2 Cement grout 3 Bentonite 4 Other .....

Grout intervals: From ..... 3 ft. to ..... 27 ft., From ..... ft. to ..... ft., From ..... ft. to ..... ft.

What is the nearest source of possible contamination:

1 Septic tank 4 Lateral lines 7 Pit privy 10 Livestock pens 14 Abandoned water well  
2 Sewer lines 5 Cess pool 8 Sewage lagoon 11 Fuel storage SMALL 15 Oil well/Gas well  
3 Watertight sewer lines 6 Seepage pit 9 Feedyard 12 Fertilizer storage 16 Other (specify below)  
13 Insecticide storageDirection from well? South WestHow many feet? 65

FROM	TO	LITHOLOGIC LOG	FROM	TO	PLUGGING INTERVALS
0	3	Shale Gray	81	85	LIME Gray
3	8	Clay Red			
8	9	LIME TAN			
9	11	Shale TAN			
11	27	LIME TAN & Blue Flint			
27	29	Shale TAN			
29	42	LIME TAN & Blue Flint			
42	45	Shale Gray			
45	46	LIME Gray			
46	54	Shale - Gray to Blue Green			
54	55	LIME			
55	64	Shale Red			
64	69	LIME Gray			
69	81	Shale Gray			

7 CONTRACTOR'S OR LANDOWNER'S CERTIFICATION: This water well was (1) constructed, (2) reconstructed, or (3) plugged under my jurisdiction and was completed on (mo/day/year) Feb 22-06 and this record is true to the best of my knowledge and belief. Kansas Water Well Contractor's Licence No 210 This Water Well Record was completed on (mo/day/yr) Mar 13-06 under the business name of ZINN Water Well Drilling by (signature) Joseph A. Zinn