WATER WELL RECORD Form WWC-5 KSA 82a-1212

1 LOCATION OF WATER WELL: County: Morris | Fraction: NE ¼ NE¼ NE¼ | Section Number: 23 | Township Number: T 15 S | Range Number: R 9 (E) W

Distance and direction from nearest town or city street address of well if located within city? 6 East 4¾ North of Center of Council Grove Squarred off on Map

2 WATER WELL OWNER: Glen Yadon
RR#, St. Address, Box # : Rt 1
City, State, ZIP Code : Council Grove, Ks 66846
Board of Agriculture, Division of Water Resources
Application Number:

3 LOCATE WELL'S LOCATION WITH AN "X" IN SECTION BOX:

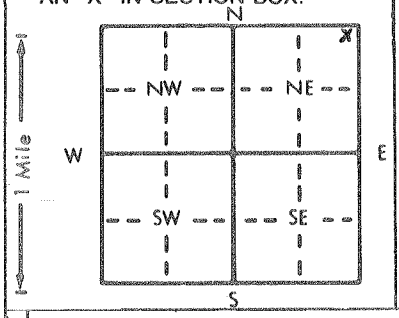

4 DEPTH OF COMPLETED WELL 135 ft. ELEVATION:
Depth(s) Groundwater Encountered 1. 36 ft. 2. ft. 3. ft.
WELL'S STATIC WATER LEVEL 32.5 ft. below land surface measured on mo/day/yr Apr. 9 89
Pump test data: Well water was ft. after hours pumping gpm
Est. Yield 2 gpm: Well water was ft. after hours pumping gpm
Bore Hole Diameter 8 in. to 24 ft., and in. to ft.
WELL WATER TO BE USED AS: 5 Public water supply 8 Air conditioning 11 Injection well
(1) Domestic 3 Feedlot 6 Oil field water supply 9 Dewatering 12 Other (Specify below)
2 Irrigation 4 Industrial 7 Lawn and garden only 10 Monitoring well
Was a chemical/bacteriological sample submitted to Department? Yes No X ; If yes, mo/day/yr sample was submitted
Water Well Disinfected? (Yes) No

5 TYPE OF BLANK CASING USED: 1 Steel 2 PVC 3 RMP (SR) 4 ABS 5 Wrought iron 6 Asbestos-Cement 7 Fiberglass 8 Concrete tile 9 Other (specify below)
CASING JOINTS: Glued X Clamped Welded Threaded
Blank casing diameter 5 in. to 35 ft., Dia in. to ft., Dia in. to ft.
Casing height above land surface 16 in., weight lbs./ft. Wall thickness or gauge No. SDR 26

TYPE OF SCREEN OR PERFORATION MATERIAL: (7) PVC
1 Steel 3 Stainless steel 5 Fiberglass 8 RMP (SR) 10 Asbestos-cement
2 Brass 4 Galvanized steel 6 Concrete tile 9 ABS 11 Other (specify) 12 None used (open hole)

SCREEN OR PERFORATION OPENINGS ARE: (8) Saw cut 11 None (open hole)
1 Continuous slot 3 Mill slot 5 Gauzed wrapped 6 Wire wrapped 9 Drilled holes
2 Louvered shutter 4 Key punched 7 Torch cut 10 Other (specify)

SCREEN-PERFORATED INTERVALS: From 35 ft. to 135 ft., From ft. to ft.
From ft. to ft., From ft. to ft.
GRAVEL PACK INTERVALS: From NONE ft. to ft., From ft. to ft.
From ft. to ft., From ft. to ft.

6 GROUT MATERIAL: (1) Neat cement 2 Cement grout 3 Bentonite 4 Other
Grout Intervals: From 3 ft. to 24 ft., From ft. to ft., From ft. to ft.

What is the nearest source of possible contamination:
1 Septic tank (4) Lateral lines 7 Pit privy 10 Livestock pens 14 Abandoned water well
2 Sewer lines 5 Cess pool 8 Sewage lagoon 11 Fuel storage 15 Oil well/Gas well
3 Watertight sewer lines 6 Seepage pit 9 Feedyard 12 Fertilizer storage 16 Other (specify below)
13 Insecticide storage
Direction from well? North How many feet? 200

FROM	TO	LITHOLOGIC LOG
0	4	Top Soil
4	67	Clay Brn
7	17	Lime Lite Some Shale
17	27	Shale Gray
27	35	Lime Lite TAN
35	37	Shale Redish
37	46	Lime White / Blue Flint
46	51	Shale Gray
51	58	Red Rock
58	66	Lime White
66	77	Shale DK Gray
77	81	Lime Gray
81	89	Shale Gray & Green
89	93	Lime Lite Gray
93	98	Shale Green
98	102	Lime Lite Gray
102	106	Shale DK Gray
106	107	Lime Gray
107	114	Shale DK Gray
114	118	Lime Gray
118	122	Shale Green
122	126	Red Rock (very Lite)
126	127	Lime Lite TAN
127	132	Shale DK Gray
132	135	Lime Gray

PLUGGING INTERVALS

7 CONTRACTOR'S OR LANDOWNER'S CERTIFICATION: This water well was (1) constructed, (2) reconstructed, or (3) plugged under my jurisdiction and was completed on (mo/day/year) Apr. 9 89 and this record is true to the best of my knowledge and belief. Kansas Water Well Contractor's License No. 218 This Water Well Record was completed on (mo/day/yr) May. 15. 89
under the business name of Zinn Water Well Drlg by (signature) Joseph A. Zinn

INSTRUCTIONS: Use typewriter or ball point pen. *PLEASE PRESS FIRMLY* and *PRINT* clearly. Please fill in blanks, underline or circle the correct answers. Send top three copies to Kansas Department of Health and Environment, Bureau of Water Protection, Topeka, Kansas 66620-7320. Telephone: 913-296-5514. Send one to WATER WELL OWNER and retain one for your records.