

122

Bushong

jd

USE TYPEWRITER OR BALL POINT PEN-PRESS FIRMLY, PRINT CLEARLY.


WATER WELL RECORD
KSA 82a-1201-1215

Kansas Department of Health and Environment-Division of Environment
(Water well Contractors)
Topeka, Kansas 66620

1. Location of well: County Wabaunsee Fraction DDD Section number 14 Township number T 15 S R 9 Range number EW

2. Distance and direction from nearest town or city: 6 mile East and 5 mile North of Council Grove Street address of well location if in city: _____

3. Owner of well: Martin Vahsholtz R.R. or street: Rt 3 Council Grove, Kan City, state, zip code: _____

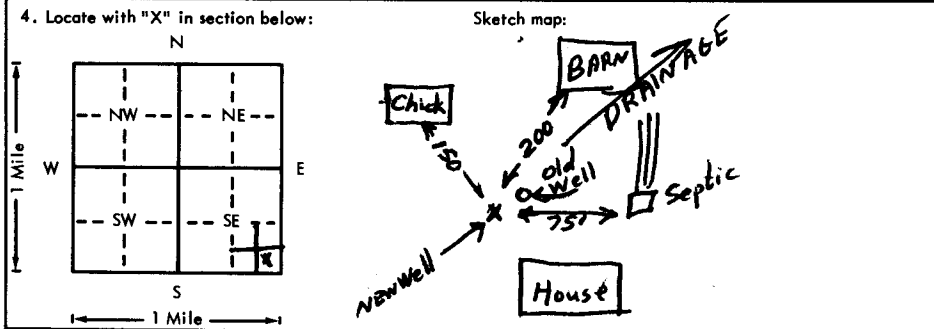

6. Bore hole dia. 6 1/4 in. Completion date 4-13-76
Well depth 55 ft.

7. Cable tool Rotary Driven Dug
 Hollow rod Jetted Bored Reverse rotary

8. Use: Domestic Public supply Industry
 Irrigation Air conditioning Stock
 Lawn Oil field water Other

9. Casing: Material PVC Height: Above or below
Threaded Welded glw Surface 18 in.
 RMP PVC Weight _____ lbs./ft.
Dia. 5 in. to 40 ft. depth Wall Thickness: inches or
Dia. _____ in. to _____ ft. depth gage No. 200

5. Type and color of material	From	To
Top - Blk	0	5
Flint Gravel with Brn Clay	5	11
LIME - Yel	11	18
Shale - like Gray	18	36
LIME - wht	36	38
Shale - Redish Brown	38	40
Shale - Green 40 water	40	45
Red Rock - Red	45	53
Shale - Gray	53	55
(Use a second sheet if needed)		

10. Screen: Manufacturer's name Sunflower
Type RMP Dia. 5"
 Slot gauze 1/8" Length 15'
Set between 40 ft. and 55 ft.
_____ ft. and _____ ft.
Gravel pack? NO Size range of material _____

11. Static water level: _____ mo./day/yr.
35 ft. below land surface Date 4-13-76

12. Pumping level below land surfaces:
_____ ft. after _____ hrs. pumping _____ g.p.m.
_____ ft. after _____ hrs. pumping _____ g.p.m.
Estimated maximum yield 10 g.p.m.

13. Water sample submitted: _____ mo./day/yr.
Yes No Date _____

14. Well head completion:
_____ Pitless adapter 18 Inches above grade

15. Well grouted? Yes
With: _____ Neat cement _____ Bentonite Concrete
Depth: From 3 ft. to 13 ft.

16. Nearest source of possible contamination:
ft. 25 Direction E Type Septic
Well disinfected upon completion? Yes No

17. Pump: Not installed
Manufacturer's name _____
Model number _____ HP _____ Volts _____
Length of drop pipe _____ ft. capacity _____ g.p.m.
Type:
 Submersible Turbine
 Jet Reciprocating
 Centrifugal Other

18. Elevation: 1404
Topography: RM
 Hill
 Slope
 Upland
 Valley

19. Remarks: Concret slab to be installed by customer x Martin Vahsholtz

20. Water well contractor's certification:
This well was drilled under my jurisdiction and this report is true to the best of my knowledge and belief.
Zinn Water Well Drilling, 218
Business name _____ License No. _____
Address West Springs, Kan
Signed Joseph A. Zinn Date 4-17-76
Authorized representative

T 15 S R 9 E W 14 SE SESE 1/4 1/4 1/4