

WATER WELL RECORD

Form WWC-5


Division of Water Resources App. No.

| | | | | |
|---|---|----------------------------|-------------------------------|---|
| 1 LOCATION OF WATER WELL: County: <u>Morris</u> | Fraction <u>SE 1/4 NW 1/4 SW 1/4</u> 1/4 | Section Number <u>4</u> | Township No. T <u>16</u> S | Range Number R <u>7</u> <input checked="" type="checkbox"/> E <input type="checkbox"/> W |
|---|---|----------------------------|-------------------------------|---|

Street/Rural Address of Well Location; if unknown, distance & direction from nearest town or intersection: If at owner's address, check here 3 1/2 N Wilsey

Global Positioning System (GPS) information:
 Latitude: (in decimal degrees)
 Longitude: (in decimal degrees)
 Elevation:
 Datum: WGS 84, NAD 83, NAD 27

| | |
|--|--|
| 2 WATER WELL OWNER: <u>Chad T. Schouser</u> RR#, Street Address, Box #: <u>1752 U.S. Hwy 56</u> City, State, ZIP Code: <u>Wilsey, KS. 66873</u> | Collection Method: <input type="checkbox"/> GPS unit (Make/Model:) <input type="checkbox"/> Digital Map/Photo, <input type="checkbox"/> Topographic Map, <input type="checkbox"/> Land Survey Est. Accuracy: <input type="checkbox"/> <3 m, <input type="checkbox"/> 3-5 m, <input type="checkbox"/> 5-15 m, <input type="checkbox"/> >15 m |
|--|--|

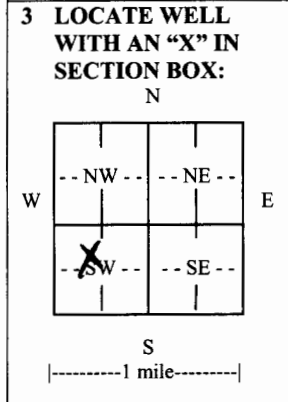

4 DEPTH OF COMPLETED WELL 120 ft.

Depth(s) Groundwater Encountered (1).....5.5 ft. (2)..... ft. (3)..... ft.

WELL'S STATIC WATER LEVEL.....2.5 ft. below land surface measured on mo/day/yr. 7-20-10

Pump test data: Well water was ft. after hours pumping gpm
 EST. YIELD.....4 gpm, Well water was ft. after hours pumping gpm

Bore Hole Diameter 8 1/2 in. to 120 ft., and in. to ft.

WELL WATER TO BE USED AS: Public water supply Geothermal Injection well
 Domestic Feedlot Oil field water supply Dewatering Other (Specify below)
 Irrigation Industrial Domestic-lawn & garden Monitoring well

Was a chemical/bacteriological sample submitted to Department? Yes No
 If yes, mo/day/yr sample was submitted.....

Water well disinfected? Yes No

5 TYPE OF CASING USED: Steel PVC Other

CASING JOINTS: Glued Clamped Welded Threaded
 Casing diameter 5 in. to 120 ft., Diameter in. to ft., Diameter in. to ft.
 Casing height above land surface..... 18 in., Weight SDR 26 lbs./ft., Wall thickness or gauge No. 214

TYPE OF SCREEN OR PERFORATION MATERIAL:
 Steel Stainless Steel PVC Other (Specify)
 Brass Galvanized Steel None used (open hole)

SCREEN OR PERFORATION OPENINGS ARE:
 Continuous slot Mill slot Gauze wrapped Torch cut Drilled holes None (open hole)
 Louvered shutter Key punched Wire wrapped Saw cut Other (specify)

SCREEN-PERFORATED INTERVALS: From 4.5 ft. to 6.5 ft., From 8.5 ft. to 120 ft.
 From ft. to ft., From ft. to ft.

GRAVEL PACK INTERVALS: From 2.0 ft. to 120 ft., From ft. to ft.
 From ft. to ft., From ft. to ft.

6 GROUT MATERIAL: Neat cement Cement grout Bentonite Other

Grout Intervals: From 0 ft. to 20 ft., From ft. to ft., From ft. to ft.

What is the nearest source of possible contamination:
 Septic tank Lateral lines Pit privy Livestock pens Insecticide storage Other (specify below)
 Sewer lines Cesspool Sewage lagoon Fuel storage Abandoned water well
 Watertight sewer lines Seepage pit Feedyard Fertilizer storage Oil well/gas well

Direction from well .. N.W. Distance from well .. 150 +

| FROM | TO | LITHOLOGIC LOG | FROM | TO | LITHO. LOG (cont.) or PLUGGING INTERVALS |
|-----------|------------|------------------------|------|----|--|
| <u>0</u> | <u>3</u> | <u>Top Soil</u> | | | |
| <u>3</u> | <u>53</u> | <u>Lime Hard</u> | | | |
| <u>53</u> | <u>56</u> | <u>Water</u> | | | |
| <u>56</u> | <u>120</u> | <u>Hard Gray Shale</u> | | | |

7 CONTRACTOR'S OR LANDOWNER'S CERTIFICATION: This water well was constructed, reconstructed, or plugged under my jurisdiction and was completed on (mo/day/year) .. 7-20-10 and this record is true to the best of my knowledge and belief.
 Kansas Water Well Contractor's License No. 188 This Water Well Record was completed on (mo/day/year) .. 7-29-10
 under the business name of Backhaus Drilling by (signature) Paul A. Backhaus

INSTRUCTIONS: Use typewriter or ball point pen. PLEASE PRESS FIRMLY and PRINT clearly. Please fill in blanks and check the correct answers. Send three copies (white, blue, pink) to Kansas Department of Health and Environment, Bureau of Water, Geology Section, 1000 SW Jackson St., Suite 420, Topeka, Kansas 66612-1367. Telephone 785-296-5522. Send one copy to WATER WELL OWNER and retain one for your records. Include fee of \$5.00 for each constructed well. Visit us at <http://www.kdheks.gov/waterwell/index.html>.