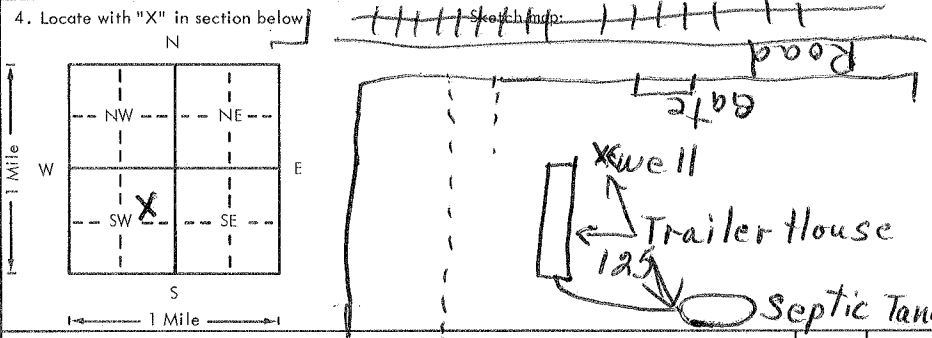


USE TYPEWRITER OR BALL  
POINT PEN-PRESS FIRMLY,  
PRINT CLEARLY.

WATER WELL RECORD  
KSA 82a-1201-1215

Kansas Department of Health and  
Environment-Division of Environment  
(Water well Contractors)  
Topeka, Kansas 66620

1. Location of well:		County <b>Lyon</b>	Fraction <b>SE 1/4 NE 1/4 SW 1/4</b>	Section number <b>24</b>	Township number <b>16</b>	Range number <b>10</b>
2. Distance and direction from nearest town or city: Street address of well location if in city: <b>Bushong, Kan,</b>				3. Owner of well: <b>K. W. Houk</b> R.R. or street: City, state, zip code: <b>Americus, Kan, 66835</b>		
4. Locate with "X" in section below 				6. Bore hole dia. <b>8</b> in. Completion date <b>10/12/78</b> Well depth <b>55</b> ft.		
5. Type and color of material				7. <input checked="" type="checkbox"/> Cable tool <input type="checkbox"/> Rotary <input type="checkbox"/> Driven <input type="checkbox"/> Dug <input type="checkbox"/> Hollow rod <input type="checkbox"/> Jetted <input type="checkbox"/> Bored <input type="checkbox"/> Reverse rotary		
Top Soil				8. Use: <input checked="" type="checkbox"/> Domestic <input type="checkbox"/> Public supply <input type="checkbox"/> Industry <input type="checkbox"/> Irrigation <input type="checkbox"/> Air conditioning <input type="checkbox"/> Stock <input type="checkbox"/> Lawn <input type="checkbox"/> Oil field water <input type="checkbox"/> Other		
Clay, Yellow, Light, Soft, F. With Rock				9. Casing: Material <b>Pist</b> Height: Above or below Threaded <input type="checkbox"/> Welded <input checked="" type="checkbox"/> Surface <b>16</b> in. RMP <input type="checkbox"/> PVC <input type="checkbox"/> Weight <b>1.5</b> lbs./ft. Dia. <b>5</b> in. to <b>55</b> ft. depth Wall Thickness: inches or Dia. <b>5</b> in. to <b>55</b> ft. depth gage No. <b>200</b>		
Clay, Yellow, Dark, Soft, F.				10. Screen: Manufacturer's name <b>Sunflower</b> <b>Sub set styerne</b> Type <b>200</b> Dia. <b>5</b> Slot/gauze <b>1/8</b> Length <b>10</b> Set between <b>45</b> ft. and <b>55</b> ft. ft. and <b>55</b> ft. Gravel pack? <input checked="" type="checkbox"/> Size range of material <b>4-12</b>		
Shale, Gray, Light H.				11. Static water level: <b>39</b> ft. below land surface Date <b>9/24/78</b>		
Shale, Gray, V. Dark & Hard				12. Pumping level below land surfaces: ft. after hrs. pumping g.p.m. ft. after hrs. pumping g.p.m. Estimated maximum yield g.p.m.		
Rock <del>Yellow</del> , Gray Very Hard				13. Water sample submitted: mo./day/yr. Yes <input checked="" type="checkbox"/> No <input type="checkbox"/> Date		
Shale, Light Gray, Soft				14. Well head completion: Pitless adapter _____ Inches above grade		
Rock, Yellow, Gray, Hard				15. Well grouted? <b>Yes</b> With: <input checked="" type="checkbox"/> Neat cement <input type="checkbox"/> Bentonite <input type="checkbox"/> Concrete Depth: From <b>0</b> ft. to <b>12</b> ft.		
Shale, Dark Gray, Hard				16. Nearest source of possible contamination: ft. <b>125</b> Direction <b>South</b> Type <b>Septic</b> Well disinfected upon completion? <input checked="" type="checkbox"/> Yes <input type="checkbox"/> No		
(Use a second sheet if needed)				17. Pump: <input checked="" type="checkbox"/> Not installed Manufacturer's name _____ Model number _____ HP _____ Volts _____ Length of drop pipe _____ ft. capacity _____ g.p.m. Type: <input type="checkbox"/> Submersible <input type="checkbox"/> Turbine <input type="checkbox"/> Jet <input type="checkbox"/> Reciprocating <input type="checkbox"/> Centrifugal <input type="checkbox"/> Other		
18. Elevation:		19. Remarks:		20. Water well contractor's certification: This well was drilled under my jurisdiction and this report is true to the best of my knowledge and belief. <b>C &amp; C Well Drilling 346</b> Business name <b>C &amp; C Well Drilling</b> License No. <b>346</b> Address <b>Box 31, Americus, Kan, 66835</b> Signed <b>Mark Regan</b> Date <b>10/20/78</b> Authorized representative		

Forward the white, blue and pink copies to the Department of Health and Environment

Form WWC-5