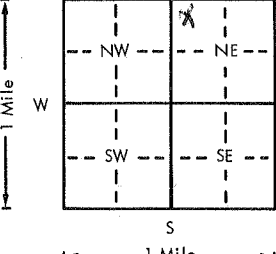
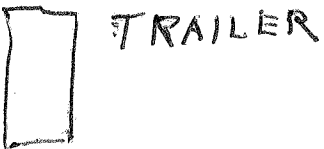


USE TYPEWRITER OR BALL
POINT PEN-PRESS FIRMLY,
PRINT CLEARLY.

WATER WELL RECORD
KSA 82a-1201-1215

Kansas Department of Health and
Environment-Division of Environment
(Water well Contractors)
Topeka, Kansas 66620

1. Location of well:	County LYON	Fraction NW 1/4 NE 1/4	Section number 25	Township number T 16 S R 10 E/W	Range number
2. Distance and direction from nearest town or city: 3/4 MILE SOUTH OF BUSHONG KS		3. Owner of well: MANILY E CORNWELL R.R. or street: BOX 202 City, state, zip code: AMERICUS KANSAS 66835			
4. Locate with "X" in section below: 		Sketch map: 		6. Bore hole dia. 4 in. Completion date 4-15-76 Well depth 60 ft.	
5. Type and color of material		From	To	7. <input checked="" type="checkbox"/> Cable tool <input type="checkbox"/> Rotary <input type="checkbox"/> Driven <input type="checkbox"/> Dug <input type="checkbox"/> Hollow rod <input type="checkbox"/> Jetted <input type="checkbox"/> Bored <input type="checkbox"/> Reverse rotary	
DIRT BLACK		0	5	8. Use: <input checked="" type="checkbox"/> Domestic <input type="checkbox"/> Public supply <input type="checkbox"/> Industry <input type="checkbox"/> Irrigation <input type="checkbox"/> Air conditioning <input type="checkbox"/> Stock <input type="checkbox"/> Lawn <input type="checkbox"/> Oil field water <input type="checkbox"/> Other	
SHALE RED		5	8	9. Casing: Material STEEL Height/Above or below Threaded <input type="checkbox"/> Welded <input type="checkbox"/> Surface 16 in. RMP <input type="checkbox"/> PVC <input type="checkbox"/> Weight <input type="checkbox"/> lbs./ft.	
ROCK YELLOW		8	12	Dia. 5 in. to 20 ft. depth Wall Thickness: inches or Dia. <input type="checkbox"/> in. to <input type="checkbox"/> ft. depth gage No. <input type="checkbox"/>	
SHALE BLUE		12	20	10. Screen: Manufacturer's name JESS & LOWELL Type 200 Dia. 5 Slot/gauze SAW BLADE Length 20 Set between 20 ft. and 60 ft. Gravel pack? <input type="checkbox"/> Size range of material <input type="checkbox"/>	
LIME GRAY		20	29	11. Static water level: <input type="checkbox"/> mo./day/yr. 20 ft. below land surface Date 4-15-76	
SHALE BLUE		29	35	12. Pumping level below land surfaces: <input type="checkbox"/> ft. after <input type="checkbox"/> hrs. pumping <input type="checkbox"/> g.p.m. <input type="checkbox"/> ft. after <input type="checkbox"/> hrs. pumping <input type="checkbox"/> g.p.m. Estimated maximum yield <input type="checkbox"/> g.p.m.	
LIME GRAY		35	38	13. Water sample submitted: <input type="checkbox"/> mo./day/yr. <input type="checkbox"/> Yes <input checked="" type="checkbox"/> No Date <input type="checkbox"/>	
SHALE BLUE		38	46	14. Well head completion: <input checked="" type="checkbox"/> Pitless adapter 16 inches above grade	
LIME WHITE		46	55	15. Well grouted? <input checked="" type="checkbox"/> With: <input type="checkbox"/> Neat cement <input type="checkbox"/> Bentonite <input checked="" type="checkbox"/> Concrete Depth: From 0 ft. to 15 ft.	
LIME GRAY		55	60	16. Nearest source of possible contamination: ft. 100 Direction SOUTH Type SEWER LINE Well disinfected upon completion? <input checked="" type="checkbox"/> Yes <input type="checkbox"/> No	
(Use a second sheet if needed)				17. Pump: <input type="checkbox"/> Not installed Manufacturer's name PUMPER Model number <input type="checkbox"/> HP 1/2 Volts 230 Length of drop pipe 51 ft. capacity <input type="checkbox"/> g.p.m. Type: <input checked="" type="checkbox"/> Submersible <input type="checkbox"/> Turbine <input type="checkbox"/> Jet <input type="checkbox"/> Reciprocating <input type="checkbox"/> Centrifugal <input type="checkbox"/> Other	
18. Elevation:	19. Remarks: to N E		20. Water well contractor's certification: This well was drilled under my jurisdiction and this report is true to the best of my knowledge and belief. L H HARRIS 156 Business name License No. Address 13 SOUTH BELLEVUE Signed R. M. HARRIS Date 4-28-76 Authorized representative		

Forward the white, blue and pink copies to the Department of Health and Environment

Form WWC-5