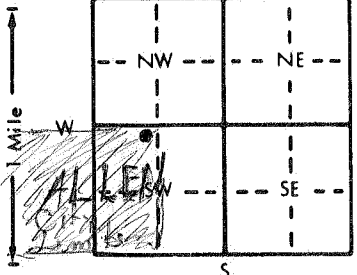


1 LOCATION OF WATER WELL: County: <u>Lyon</u>		Fraction <u>NE 1/8 Lot #41 NW 1/4 SW 1/4</u>	Section Number <u>15</u>	Township Number <u>T 16S</u>	Range Number <u>R 11</u> EW																														
Distance and direction from nearest town or city street address of well if located within city? <u>City limits of Allen - NE corner of city limits Rush street</u>																																			
2 WATER WELL OWNER: RR#, St. Address, Box # : <u>William & Anna Buckbee Box 24 Allen, KS 66833</u> City, State, ZIP Code : <u>Allen, KS 66833</u> Board of Agriculture, Division of Water Resource Application Number:																																			
3 LOCATE WELL'S LOCATION WITH AN "X" IN SECTION BOX: 		4 DEPTH OF COMPLETED WELL: <u>17</u> ft. ELEVATION: Depth(s) Groundwater Encountered 1. <u>10</u> ft. 2. ft. 3. ft. WELL'S STATIC WATER LEVEL <u>4.70</u> ft. below land surface measured on mo/day/yr <u>10/11/93</u> Pump test data: Well water was ft. after hours pumping gpm Est. Yield gpm: Well water was ft. after hours pumping gpm Bore Hole Diameter . in. to <u>3 1/2 to 17</u> ft. and . in. to ft. WELL WATER TO BE USED AS: <div style="display: flex; justify-content: space-between;"> <div> 1 Domestic 2 Irrigation </div> <div> 3 Feedlot 4 Industrial </div> <div> 5 Public water supply 6 Oil field water supply 7 Lawn and garden only </div> <div> 8 Air conditioning 9 Dewatering 10 Monitoring well </div> <div> 11 Injection well 12 Other (Specify below) </div> </div> Was a chemical/bacteriological sample submitted to Department? Yes.....No. <input checked="" type="checkbox"/> ; If yes, mo/day/yr sample was submitted Water Well Disinfected? Yes <input checked="" type="checkbox"/> No																																	
5 TYPE OF BLANK CASING USED: <div style="display: flex; justify-content: space-between;"> <div> 1 Steel 2 PVC </div> <div> 3 RMP (SR) 4 ABS </div> <div> 5 Wrought iron 6 Asbestos-Cement 7 Fiberglass </div> <div> 8 Concrete tile 9 Other (specify below) <u>Rock lined</u> </div> <div> CASING JOINTS: Glued Welded Threaded </div> </div> Blank casing diameter <u>48</u> in. to ft., Dia . in. to ft., Dia . in. to ft. Casing height above land surface . in., weight . lbs./ft. Wall thickness or gauge No. . TYPE OF SCREEN OR PERFORATION MATERIAL: <div style="display: flex; justify-content: space-between;"> <div> 1 Steel 2 Brass </div> <div> 3 Stainless steel 4 Galvanized steel </div> <div> 5 Fiberglass 6 Concrete tile </div> <div> 7 PVC 8 RMP (SR) 9 ABS </div> <div> 10 Asbestos-cement 11 Other (specify) 12 None used (open hole) </div> </div> SCREEN OR PERFORATION OPENINGS ARE: <div style="display: flex; justify-content: space-between;"> <div> 1 Continuous slot 2 Louvered shutter </div> <div> 3 Mill slot 4 Key punched </div> <div> 5 Gauzed wrapped 6 Wire wrapped 7 Torch cut </div> <div> 8 Saw cut 9 Drilled holes 10 Other (specify) </div> <div> 11 None (open hole) </div> </div> SCREEN-PERFORATED INTERVALS: From <u>NA</u> ft. to <u>NA</u> ft., From ft. to ft., From ft. to ft. GRAVEL PACK INTERVALS: From <u>8 tons</u> ft. to <u>17</u> ft., From <u>10</u> ft. to <u>10</u> ft., From <u>10</u> ft. to <u>10</u> ft. From <u>Clay compacted</u> ft. to <u>5</u> ft., From <u>6" Sodium</u> ft. to <u>4 1/2</u> ft., From <u>Top topsoil</u> ft. to <u>Top topsoil</u> ft.																																			
6 GROUT MATERIAL: <div style="display: flex; justify-content: space-between;"> <div> 1 Neat cement 2 Cement grout 3 Bentonite </div> <div> 4 Other </div> </div> Grout Intervals: From <u>5</u> ft. to <u>4.5</u> ft., From ft. to ft., From ft. to ft. What is the nearest source of possible contamination: <div style="display: flex; justify-content: space-between;"> <div> 1 Septic tank 2 Sewer lines 3 Watertight sewer lines </div> <div> 4 Lateral lines 5 Cess pool 6 Seepage pit </div> <div> 7 Pit privy 8 Sewage lagoon 9 Feedyard </div> <div> 10 Livestock pens 11 Fuel storage 12 Fertilizer storage 13 Insecticide storage </div> <div> 14 Abandoned water well 15 Oil well/Gas well 16 Other (specify below) <u>5 to 6 ft. from SE House corner foundation</u> </div> </div> Direction from well? <table border="1" style="width:100%; border-collapse: collapse;"> <thead> <tr> <th>FROM</th> <th>TO</th> <th>LITHOLOGIC LOG</th> <th>FROM</th> <th>TO</th> <th>PLUGGING INTERVALS</th> </tr> </thead> <tbody> <tr> <td>0</td> <td>4 1/2</td> <td>Clay (Topsoil)</td> <td></td> <td></td> <td></td> </tr> <tr> <td>4 1/2</td> <td>5</td> <td>Sodium Bentonite</td> <td></td> <td></td> <td></td> </tr> <tr> <td>5</td> <td>10</td> <td>Clay compacted sub soil</td> <td></td> <td></td> <td></td> </tr> <tr> <td>10</td> <td>17</td> <td>Gravel</td> <td></td> <td></td> <td></td> </tr>
7 CONTRACTOR'S OR LANDOWNER'S CERTIFICATION: This water well was (1) constructed, (2) reconstructed, or <input checked="" type="checkbox"/> plugged under my jurisdiction and was completed on (mo/day/year) <u>10/19/93</u> and this record is true to the best of my knowledge and belief. Kansas Water Well Contractor's License No. <u>None</u> This Water Well Record was completed on (mo/day/yr) <u>10/18/93</u> under the business name of <u>None</u> by (signature) <u>William & Anna Buckbee</u>																																			