


1 LOCATION OF WATER WELL: Fraction Section Number Township Number Range Number
 County: LYON NW 1/4 NW 1/4 SE 10 16 11 EA

Distance and direction from nearest town or city street address of well if located within city?
1 North 1/2 West Allen Ks

2 WATER WELL OWNER: Brian Keith
 RR #, St. Address, Box #: 3505 RdL Board of Agriculture, Division of Water Resources
 City, State, ZIP Code: Allen Ks 66833 Application Number:

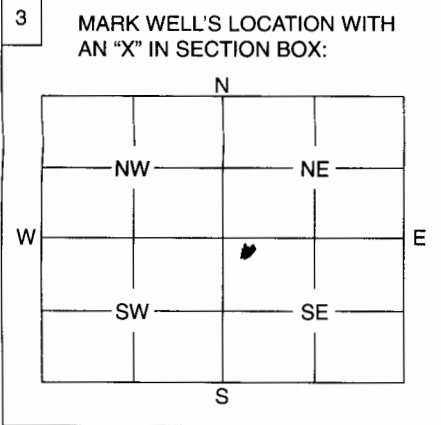

4 DEPTH OF WELL 5.0 ft.
 WELL'S STATIC WATER LEVEL 4' ft.
 WELL WAS USED AS:
 1 Domestic 5 Public Water Supply 9 Dewatering
 2 Irrigation 6 Oil Field Water Supply 10 Monitoring Well
 3 Feedlot 7 Domestic (Lawn & Garden) 11 Injection Well
 4 Industrial 8 Air Conditioning 12 Other STOCK
 Was a chemical / bacteriological sample submitted to Department? Yes No X.....
 If yes, mo/day/yr sample was submitted
 Water Well Disinfected: Yes X..... No

5 TYPE OF BLANK CASING USED:
 1 Steel 3 RMP (SR) 5 Wrought 7 Fiberglass 9 Other (Specify below)
 2 PVC 4 ABS 6 Asbestos-Cement 8 Concrete Tile T.M.
 Blank casing diameter 7" in. Was casing pulled? Yes X..... No X..... If yes, how much 4'.....
 Casing height above or below land surface 14" in. Balance Driven To Bottom

6 GROUT PLUG MATERIAL: Neat cement 2 Cement grout Bentonite 4 Other
 Grout Plug Intervals: From 0 ft. to 6 ft., From ft. to ft., From to ft.
 What is the nearest source of possible contamination:
 1 Septic tank 6 Seepage pit 11 Fuel storage 16 Other (specify below)
 2 Sewer lines 7 Pit privy 12 Fertilizer storage
 3 Watertight sewer lines 8 Sewage lagoon 13 Insecticide storage
 4 Lateral lines 9 Feedyard 14 Abandoned water well
 5 Cess pool Livestock pens 15 Oil well/Gas well
 Direction from well? SE How many feet? 2000 +/- 100

| FROM | TO | PLUGGING MATERIALS |
|-----------|-----------|-------------------------|
| <u>0</u> | <u>6</u> | <u>Neat Cement</u> |
| <u>6</u> | <u>15</u> | <u>Bentonite Mix</u> |
| <u>15</u> | <u>25</u> | <u>Neat Cement</u> |
| <u>25</u> | <u>45</u> | <u>Bentonite + Sand</u> |
| <u>45</u> | <u>50</u> | <u>Old Tim Casing</u> |
| | <u>45</u> | <u>Coal Seam</u> |

6-15 TOOK WATER
22' PRODUCED 5 GPM
45'-50' TOOK A SMALL AMOUNT
WATER.
WELL IS IN POOL AREA
WATER SUPPLY LAKE

7 CONTRACTOR'S OF LANDOWNER'S CERTIFICATION: This water well was plugged under my jurisdiction and was completed on (mo/day/year) 12-5-03 and this record is true to the best of my knowledge and belief. Kansas Water Well Contractor's License No. 203 This Water Well Record was completed on (mo/day/year) 12-12-03 under the business name of McNee Drilling & Metals by (signature) gpc mcnee

INSTRUCTIONS: Use typewriter or ball point pen. Please press firmly and print clearly. Please fill in blanks, underline or circle the correct answers. Send top three copies to Kansas Department of Health and Environment, Bureau of Water, Geology Section, 1000 SW Jackson St., Ste. 420, Topeka, Kansas 66612-1367. Telephone: 785/296-5522. Send one to Water Well Owner and retain one for your records.