

CORRECTION(S) TO WATER WELL RECORD (WWC-5)

(to rectify lacking or incorrect information)

County: Lyon

Location listed as:

Section-Township-Range: 6-155-11E

Fraction ($\frac{1}{4}$ $\frac{1}{4}$ $\frac{1}{4}$): SW SW NE

Location changed to:

6-165-11E

SW SW NE

Other changes: Initial statements: _____

Changed to: _____

Comments: _____

verification method: Phone call to well driller.

initials: DRL date: 3/31/2006

submitted by: Kansas Geological Survey, Data Resources Library, 1930 Constant Ave., Lawrence, KS 66047-3726
to: Kansas Dept of Health & Environment, Bureau of Water, 1000 SW Jackson, Suite 420, Topeka, KS 66612-1367.

1 LOCATION OF WATER WELL:	Fraction	Section Number	Township Number	Range Number
County: <u>LYON</u>	<u>SW 1/4 SW 1/4 NE 1/4</u>	<u>6</u>	T <u>15</u> S	R <u>11</u> <u>EW</u>


Distance and direction from nearest town or city street address of well if located within city?

3 1/2 Mile East of 2 1/2 North of Allen

2 WATER WELL OWNER:	Board of Agriculture, Division of Water Resources
RR#, St. Address, Box # :	Application Number:
City, State, ZIP Code :	

KC & Karli Olson12277 County RoadTebbetts Mo. 65080

3 LOCATE WELL'S LOCATION WITH AN "X" IN SECTION BOX:	4 DEPTH OF COMPLETED WELL	72	ft. ELEVATION:
--	---------------------------	----	----------------

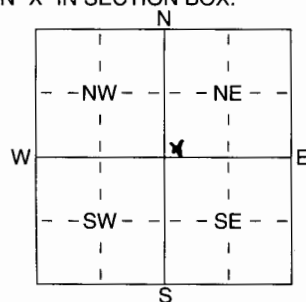

Depth(s) Groundwater Encountered 40 ft. 2 52 ft. 3 52 ft.

WELL'S STATIC WATER LEVEL 40 ft. below land surface measured on mo/day/yr Mar 11-06



WELL WATER TO BE USED AS:

5 Public water supply	8 Air conditioning	11 Injection well
6 Domestic	3 Feedlot	6 Oil field water supply
2 Irrigation	4 Industrial	7 Domestic (lawn & garden)
		10 Monitoring well

Was a chemical/bacteriological sample submitted to Department? Yes No; If yes, mo/day/yr sample was submitted Yes

Water Well Disinfected Yes No

5 TYPE OF BLANK CASING USED:	5 Wrought iron	8 Concrete tile	CASING JOINTS: Glued <u>X</u> Clamped
1 Steel	6 Asbestos-Cement	9 Other (specify below)	Welded
2 PVC	7 Fiberglass		Threaded


TYPE OF SCREEN OR PERFORATION MATERIAL:	5 Fiberglass	7 PVC	10 Asbestos-Cement
1 Steel	6 Concrete tile	8 RMP (SR)	11 Other (Specify)
2 Brass		9 ABS	12 None used (open hole)

SCREEN OR PERFORATION OPENINGS ARE:	5 Guazed wrapped	8 Saw cut	11 None (open hole)
1 Continuous slot	6 Wire wrapped	9 Drilled holes	
2 Louvered shutter	7 Torch cut	10 Other (specify)	


6 GROUT MATERIAL:	1 Neat cement	2 Cement grout	3 Bentonite	4 Other
-------------------	---------------	----------------	-------------	---------


What is the nearest source of possible contamination:

- | | | | | |
|--------------------------|-----------------|-----------------|-----------------------|--------------------------|
| 1 Septic tank | 4 Lateral lines | 7 Pit privy | 10 Livestock pens | 14 Abandoned water well |
| 2 Sewer lines | 5 Cess pool | 8 Sewage lagoon | 11 Fuel storage | 15 Oil well/Gas well |
| 3 Watertight sewer lines | 6 Seepage pit | 9 Feedyard | 12 Fertilizer storage | 16 Other (specify below) |

Direction from well? NO House - No Proposal How many feet? IN 160 Acre OPEN PASTURE

FROM	TO	LITHOLOGIC LOG	FROM	TO	PLUGGING INTERVALS
0	2.5	Top Soil Blk			
2.5	8	Aluvium in Red Clay			
8	10	LIME TAN			
10	23.5	Shale TAN 10-25			
23.5	32.5	LIME TAN 23-32			
32	35	Shale Brn			
35	42	LIME Brn			
42	46	Shale Brn			
46	52	Shale - Gray & Green			
52	60	Shale - Red			
60	72	LIME TAN			

7 CONTRACTOR'S OR LANDOWNER'S CERTIFICATION: This water well was (1) constructed, (2) reconstructed, or (3) plugged under my jurisdiction and was completed on (mo/day/year) <u>Mar 11-06</u> and this record is true to the best of my knowledge and belief. Kansas Water Well Contractor's Licence No. <u>218</u> This Water Well Record was completed on (mo/day/yr) <u>Mar 13-06</u> under the business name of <u>ZINN Water Well Drilling</u> by (signature) <u>Joseph A. Zinn</u>
--

INSTRUCTIONS: Use typewriter or ball point pen. PLEASE PRESS FIRMLY and PRINT clearly. Please fill in blanks, underline or circle the correct answers. Send two copies to Kansas Department of Health and Environment, Bureau of Water, Geology Section, 1000 SW Jackson St., Suite 420, Topeka, Kansas 66612-1367. Telephone 785-296-5522. Send one to WATER WELL OWNER and retain one for your records. Fee of \$5.00 for each constructed well.