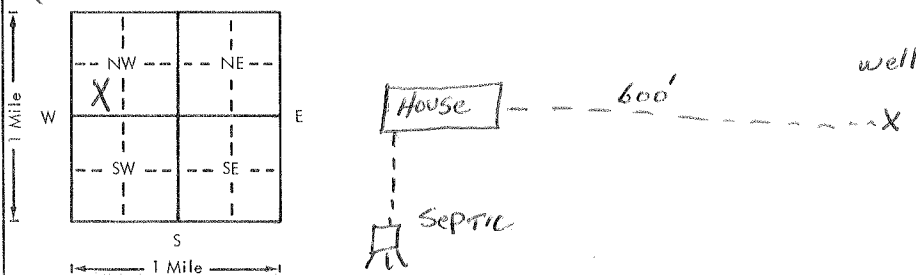


USE TYPEWRITER OR BALL
POINT PEN-PRESS FIRMLY,
PRINT CLEARLY.

WATER WELL RECORD
KSA 82a-1201-1215

Kansas Department of Health and
Environment-Division of Environment
(Water well Contractors)
Topeka, Kansas 66620

1. Location of well:	County <u>Lyon</u>	X Fraction <u>SW 1/4 SW 1/4 NW 1/4</u>	Section number <u>3</u>	Township number T <u>16</u> S	Range number R <u>12</u> E
2. Distance and direction from nearest town or city: <u>3.5 N 1 W E O F</u>		3. Owner of well: <u>W.C. Lynch</u> R.R. or street: <u>RR1 Admire, KS 66830</u> City, state, zip code:			
X. Locate with "X" in section below:		Sketch map:		6. Bore hole dia. <u>10</u> in. Completion date Well depth <u>40</u> ft. <u>8-10-79</u>	
				7. <input type="checkbox"/> Cable tool <input checked="" type="checkbox"/> Rotary <input type="checkbox"/> Driven <input type="checkbox"/> Dug <input type="checkbox"/> Hollow rod <input type="checkbox"/> Jetted <input type="checkbox"/> Bored <input type="checkbox"/> Reverse rotary	
5. Type and color of material		From	To	8. Use: <input checked="" type="checkbox"/> Domestic <input type="checkbox"/> Public supply <input type="checkbox"/> Industry <input type="checkbox"/> Irrigation <input type="checkbox"/> Air conditioning <input type="checkbox"/> Stock <input type="checkbox"/> Lawn <input type="checkbox"/> Oil field water <input type="checkbox"/> Other	
<u>Top soil</u>		<u>0</u>	<u>6</u>	9. Casing: Material <u>PVC</u> Height: <u>Above</u> or below Threaded <input type="checkbox"/> Welded <input type="checkbox"/> Surface <u>34</u> in. RMP <u>PVC 9/16</u> Weight <u>2.82</u> lbs./ft. Dia. <u>5</u> in. to <u>40</u> ft. depth Wall Thickness: inches or Dia. <u>5</u> in. to <u>40</u> ft. depth gage No. <u>1258</u>	
<u>Clay, brown</u>		<u>6</u>	<u>13</u>	10. Screen: Manufacturer's name <u>Pumpco</u> Type <u>PVC</u> Dia. <u>5</u> Slot/gauze <u>0.020</u> Length <u>10</u> Set between <u>13</u> ft. and <u>23</u> ft. ft. and <u>23</u> ft. Gravel pack? <input checked="" type="checkbox"/> Size range of material <u>0.30x0.60</u>	
<u>Chert 1/4x1/8x1/2 water bearing</u>		<u>13</u>	<u>18</u>	11. Static water level: <u>10</u> ft. below land surface Date <u>8-10-79</u> mo./day/yr.	
<u>Shale, grey</u>		<u>18</u>	<u>40</u>	12. Pumping level below land surfaces: ____ ft. after ____ hrs. pumping ____ g.p.m. ____ ft. after ____ hrs. pumping ____ g.p.m. Estimated maximum yield <u>12</u> g.p.m.	
				13. Water sample submitted: ____ mo./day/yr. <input type="checkbox"/> Yes <input checked="" type="checkbox"/> No Date	
				14. Well head completion: <u>040</u> <input type="checkbox"/> Pitless adapter <u>24</u> inches above grade	
				15. Well grouted? <input checked="" type="checkbox"/> With: <input checked="" type="checkbox"/> Neat cement <input type="checkbox"/> Bentonite <input type="checkbox"/> Concrete Depth: From <u>0</u> ft. to <u>10</u> ft.	
				16. Nearest source of possible contamination: ft. <u>600</u> Direction <u>SW</u> Type <u>Septic</u> Well disinfected upon completion? <input checked="" type="checkbox"/> Yes <input type="checkbox"/> No	
				17. Pump: <u>Not installed</u> Manufacturer's name _____ Model number _____ HP _____ Volts _____ Length of drop pipe _____ ft. capacity _____ g.p.m. Type: <input type="checkbox"/> Submersible <input type="checkbox"/> Turbine <input type="checkbox"/> Jet <input type="checkbox"/> Reciprocating <input type="checkbox"/> Centrifugal <input type="checkbox"/> Other	
		(Use a second sheet if needed)			
18. Elevation:	19. Remarks:		20. Water well contractor's certification:		
Topography: <input type="checkbox"/> Hill <input type="checkbox"/> Slope <input type="checkbox"/> Upland <input checked="" type="checkbox"/> Valley	<u>owner to install slab</u>		This well was drilled under my jurisdiction and this report is true to the best of my knowledge and belief. <u>STRADER Dalg Co</u> <u>182</u> Business name License No. Address <u>Horton, KS</u> Signed <u>Dale Ashen</u> Date <u>8-10-79</u> Authorized representative		

Forward the white, blue and pink copies to the Department of Health and Environment

Form WWC-5