

1 LOCATION OF WATER WELL: Fraction NE 1/4 NE 1/4 NE 1/4 Section Number 27 Township Number T 16 S Range Number R 12 E/W

Distance and direction from nearest town or city street address of well if located within city?

1 3/4 Mile East of Admire, Ks.


2 WATER WELL OWNER:

RR#, St. Address, Box # : Phil Mott
City, State, ZIP Code : Admire, Ks 66830

Board of Agriculture, Division of Water Resource

Application Number:

3 LOCATE WELL'S LOCATION WITH AN "X" IN SECTION BOX:

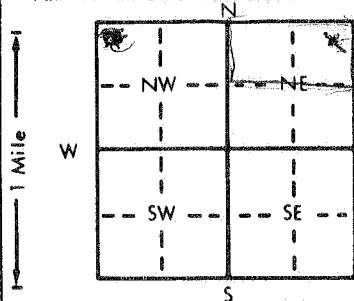

4 DEPTH OF COMPLETED WELL: 20 ft. ELEVATION:






WELL WATER USED AS: 5 Public water supply 8 Air conditioning 11 Injection well

1 Domestic 3 Feedlot 6 Oil field water supply 9 Dewatering 12 Other (Specify below)

2 Irrigation 4 Industrial 7 Lawn and garden only 10 Monitoring well

Was a chemical/bacteriological sample submitted to Department? Yes.....No.....; If yes, mo/day/yr sample was submitted

Water Well Disinfected? Yes No

5 TYPE OF BLANK CASING USED:

- 1 Steel 3 RMP (SR)
2 PVC 4 ABS

- 5 Wrought iron 8 Concrete tile
6 Asbestos-Cement 9 Other (specify below)
7 Fiberglass ROCK

CASING JOINTS: Glued Clamped

Welded

Threaded


Casing height above land surface 0 in., weight 0 lbs./ft. Wall thickness or gauge No. 0

TYPE OF SCREEN OR PERFORATION MATERIAL:

- 1 Steel 3 Stainless steel
2 Brass 4 Galvanized steel

- 5 Fiberglass 8 RMP (SR)
6 Concrete tile 9 ABS

10 Asbestos-cement

11 Other (specify) NA

12 None used (open hole)

SCREEN OR PERFORATION OPENINGS ARE:

- 1 Continuous slot 3 Mill slot
2 Louvered shutter 4 Key punched

- 5 Gauzed wrapped 8 Saw cut
6 Wire wrapped 9 Drilled holes
7 Torch cut 10 Other (specify) NA

11 None (open hole)

SCREEN-PERFORATED INTERVALS: From NA ft. to NA ft., From NA ft. to NA ft., From NA ft. to NA ft.

GRAVEL PACK INTERVALS: From NA ft. to NA ft., From NA ft. to NA ft., From NA ft. to NA ft.

6 GROUT MATERIAL:

- 1 Neat cement 2 Cement grout 3 Bentonite 4 Other


What is the nearest source of possible contamination:

- 1 Septic tank 4 Lateral lines
2 Sewer lines 5 Cess pool
3 Watertight sewer lines 6 Seepage pit

7 Pit privy

8 Sewage lagoon

9 Feedyard

10 Livestock pens

11 Fuel storage

12 Fertilizer storage

13 Insecticide storage

14 Abandoned water well

15 Oil well/Gas well

16 Other (specify below)

Direction from well?

How many feet?

FROM	TO	LITHOLOGIC LOG	FROM	TO	PLUGGING INTERVALS
<u>20</u>	<u>10</u>	<u>ROCK LINING & SAND</u>	<u>20</u>	<u>10</u>	
<u>10</u>	<u>7</u>	<u>SUB SOIL</u>	<u>10</u>	<u>7</u>	
<u>7</u>	<u>6</u>	<u>BENTONITE</u>	<u>7</u>	<u>6</u>	
<u>6</u>	<u>3</u>	<u>TOP SOIL</u>	<u>6</u>	<u>3</u>	
<u>3</u>	<u>0</u>	<u>CRAWL SPACE</u>	<u>3</u>	<u>0</u>	

7 CONTRACTOR'S OR LANDOWNER'S CERTIFICATION: This water well was (1) constructed, (2) reconstructed, or (3) plugged under my jurisdiction and was completed on (mo/day/year) 8-22-92 and this record is true to the best of my knowledge and belief. Kansas

Water Well Contractor's License No. 8-2892 This Water Well Record was completed on (mo/day/yr) 8-28-92

under the business name of Phil Mott by (signature) Phil Mott