

County: Lyon Fraction W2 NE SW SE Sec. 20 T 16 S R 12 EW

CORRECTION(S) TO WATER WELL COMPLETION RECORD (WWC-5)

(to rectify lacking or incorrect information)

Owner: Mundy Service

Location was listed as:

Location changed to:

Section-Township-Range: 20-16S-12E

20-16S-12E

Fraction ($\frac{1}{4}$ $\frac{1}{4}$ $\frac{1}{4}$): NE SW SE

W2 NE SW SE

Other changes: Initial statements: Allen County

Changed to: Lyon County

Comments: _____

Verification method: written & legal descriptions, enclosed site map,
and mapping tool & aerial photos on KGS website.

initials: APL date: 10/28/2014

Submitted by: Kansas Geological Survey, Data Resources Library, 1930 Constant Ave., Lawrence, KS 66047-3726

to: Kansas Dept of Health & Environment, Bureau of Water, 1000 SW Jackson, Suite 420, Topeka, KS 66612-1367.

Lyon Co.

20-16-17

~~KGS Copy~~

NOTE: Figures exhibited within this report are only to be used within the context of this report. Placement of property lines, wells, structures, and roads is based on the available information from county appraiser maps, surveys, site visits, and/or previous vendor reports and should be considered approximate.

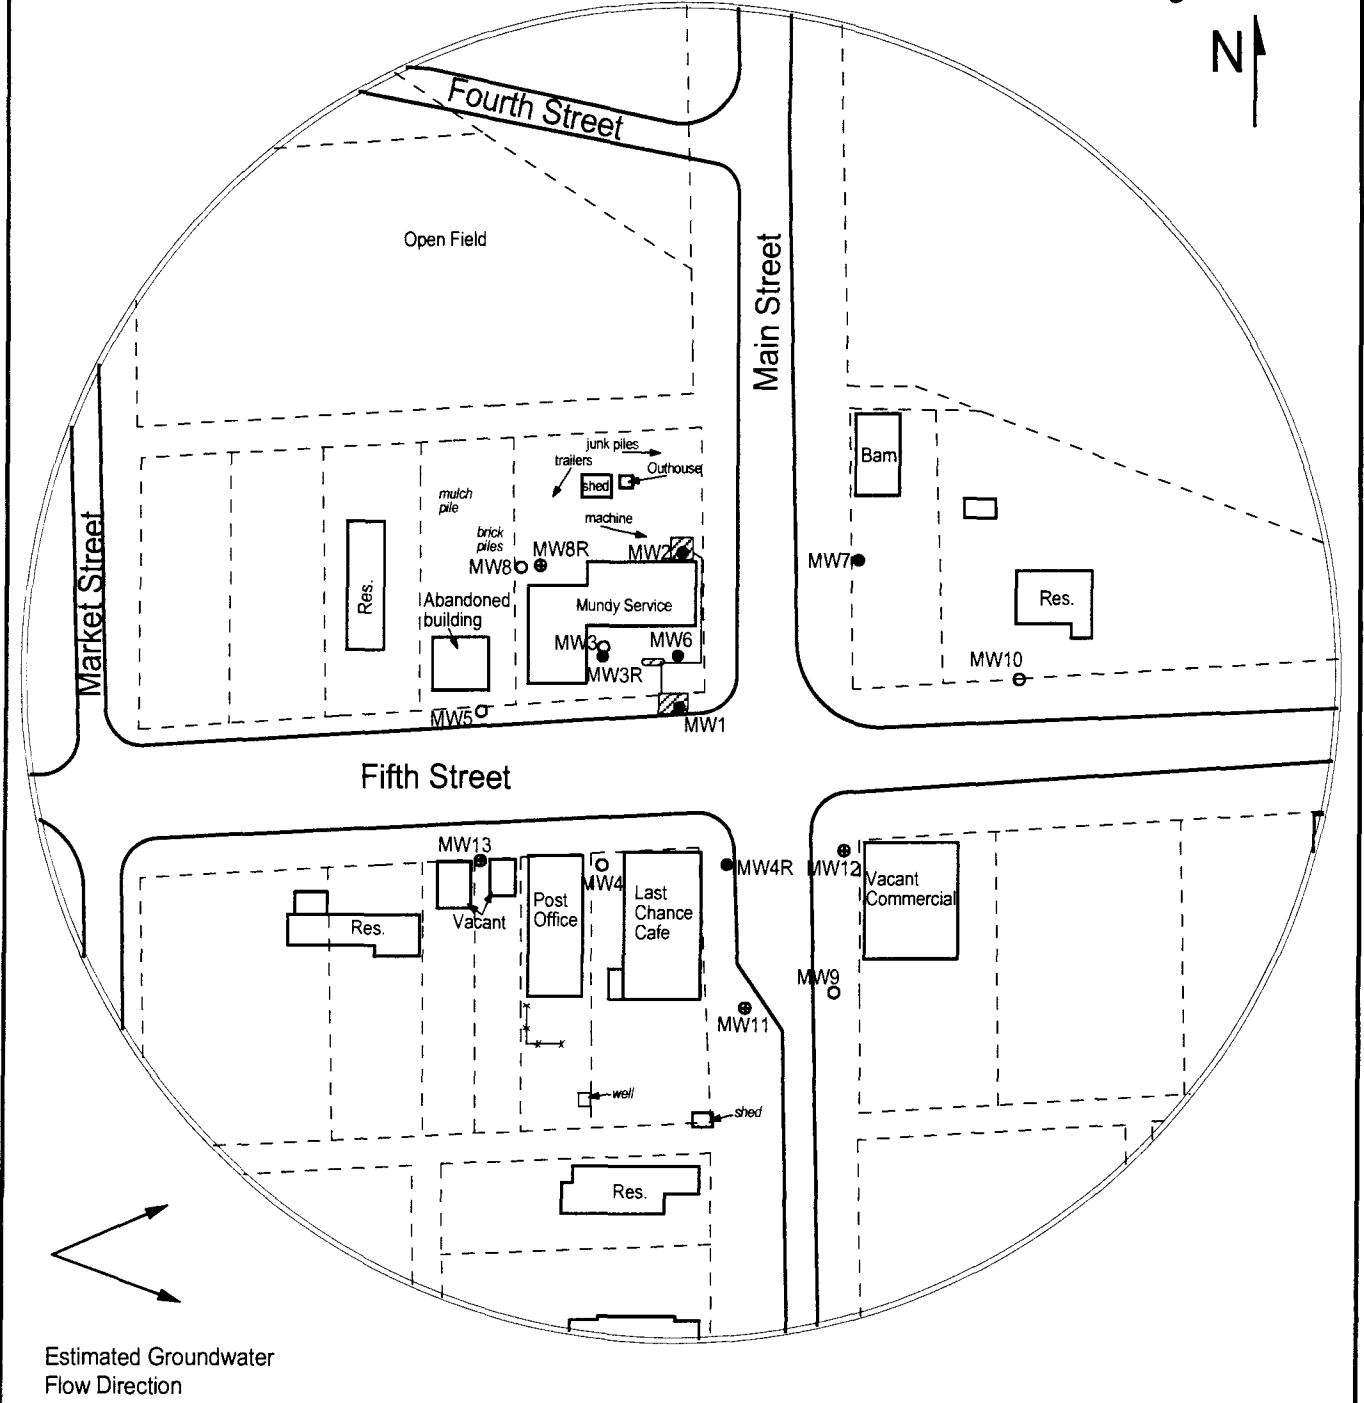


FIGURE 3 - 350 FT RADIUS AREA BASE MAP



PROJECT:

Mundy Service
5th & Main
Admire, KS
KDHE ID: U3-056-10326
Date: 3/31/14

LEGEND:

- Approximate Location of Former UST Basin, Product Line & Pump Island
- Existing Monitoring Well
- Proposed Monitoring Well
- Plugged Well
- Proposed Soil Boring
- Electric Meter
- Fire Hydrant
- Gas Meter
- Overhead Lines

NOTE: Utility depths and locations are approximate.
NOTE: MW1 was not located during the site visit.
NOTE: Access to drill SB9 and SB10 will depend on moving the trailer.
NOTE: SB9 and SB10 will be drilled to collect hydrologic samples.

1311 E 25th St. Suite B
Lawrence, KS 66046

785-841-8707 office
785-865-4282 fax

0 100 ft