

County: Lyon Fraction: S2, NW, SW, SE Sec. 20 T. 16 S R. 12 E

CORRECTION(S) to WATER WELL COMPLETION RECORD Form WWC-5 (to rectify lacking or incorrect information)

Owner: Admire Methodist Church Cistern plugged

If location corrected, was listed as:

Location changed to:

Section-Township-Range: _____

Fraction (1/4 calls): none given

S2, NW, SW, SE

Other changes: Initial statements: SWL reported as 2 ft. Plugging materials & intervals not reported.

Description of cistern location not provided.

Changed to: Only 2 ft water in cistern, so SWL 6 ft. Sand 8 - 5 ft, bentonite 5 - 4.5 ft, clay/soil 4.5 - 0 ft.

Cistern approximately 50 feet W of SW corner of Church under tree canopy.

Comments: _____

Verification method: Used USDA NRCS info attached to WWC-5 and confirmed with John D. Orear of Orear Construction, LLC.

Initials: PKC Date: 11/30/2021

Submitted by: ☐ Kansas Geological Survey, Data Resources Library, 1930 Constant Ave., Lawrence, KS 66047-3724

☒ Kansas Dept. of Health & Environment, Bureau of Water, 1000 SW Jackson, Suite 420, Topeka, KS 66612-1367

WATER WELL RECORD Form WWC-5

Division of Water
Resources App. No.

Well ID

☒ Original Record ☐ Correction ☐ Change in Well Use

1 LOCATION OF WATER WELL:

County: Lyons

Fraction

$\frac{1}{4}$ $\frac{1}{4}$ $\frac{1}{4}$ $\frac{1}{4}$

Section Number

Township Number

T 20 S 16

Range Number

R 12 E W

2 WELL OWNER: Last Name:

Business: Admire Methodist Church

Address:

Address:


City: Admire

State: Ks ZIP: 66830

Street or Rural Address where well is located (if unknown, distance and direction from nearest town or intersection): If at owner's address, check here: ☒

5th & Market

3 LOCATE WELL WITH "X" IN SECTION BOX:

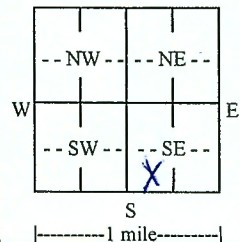

4 DEPTH OF COMPLETED WELL: ft.

Depth(s) Groundwater Encountered: 1) ft.

2) ft. 3) ft., or 4) ☒ Dry Well

WELL'S STATIC WATER LEVEL: ft.

☒ below land surface, measured on (mo-day-yr) 5/3/21

☐ above land surface, measured on (mo-day-yr)

Pump test data: Well water was ft.

after hours pumping gpm

Well water was ft.

after hours pumping gpm

Estimated Yield: gpm

Bore Hole Diameter: in. to ft. and

..... in. to ft.

5 Latitude: (decimal degrees)

Longitude: (decimal degrees)

Horizontal Datum: ☐ WGS 84 ☐ NAD 83 ☐ NAD 27

Source for Latitude/Longitude:

☐ GPS (unit make/model:)

(WAAS enabled? ☐ Yes ☐ No)

☐ Land Survey ☐ Topographic Map

☐ Online Mapper:

6 Elevation: ft. ☒ Ground Level ☐ TOC

Source: ☐ Land Survey ☐ GPS ☐ Topographic Map

☐ Other

7 WELL WATER TO BE USED AS:

1. Domestic:

☒ Household

☐ Lawn & Garden

☐ Livestock

2. ☐ Irrigation

3. ☐ Feedlot

4. ☐ Industrial

5. ☐ Public Water Supply: well ID

6. ☐ Dewatering: how many wells?

7. ☐ Aquifer Recharge: well ID

8. ☐ Monitoring: well ID

9. Environmental Remediation: well ID

☐ Air Sparge ☐ Soil Vapor Extraction

☐ Recovery ☐ Injection

10. ☐ Oil Field Water Supply: lease

11. Test Hole: well ID

☐ Cased ☐ Uncased ☐ Geotechnical

12. Geothermal: how many bores?

a) Closed Loop ☐ Horizontal ☐ Vertical

b) Open Loop ☐ Surface Discharge ☐ Inj. of Water

13. ☐ Other (specify):

Was a chemical/bacteriological sample submitted to KDHE? ☐ Yes ☒ No If yes, date sample was submitted:

Water well disinfected? ☒ Yes ☐ No

8 TYPE OF CASING USED: ☐ Steel ☐ PVC ☐ Other Brick Lining CASING JOINTS: ☐ Glued ☐ Clamped ☐ Welded ☐ Threaded

Casing diameter 7.2 in. to ft., Diameter in. to ft., Diameter in. to ft.

Casing height above land surface 6 in. Weight lbs./ft. Wall thickness or gauge No. 6

TYPE OF SCREEN OR PERFORATION MATERIAL:

☐ Steel ☐ Stainless Steel ☐ Fiberglass ☐ PVC

☐ Brass ☐ Galvanized Steel ☐ Concrete tile ☒ None used (open hole)

☒ Other (Specify) cistern sealed

SCREEN OR PERFORATION OPENINGS ARE:

☐ Continuous Slot ☐ Mill Slot ☐ Gauze Wrapped ☐ Torch Cut ☐ Drilled Holes ☒ Other (Specify) sealed

☐ Louvered Shutter ☐ Key Punched ☐ Wire Wrapped ☐ Saw Cut ☒ None (Open Hole)

SCREEN-PERFORATED INTERVALS: From ft. to ft., From ft. to ft., From ft. to ft.

GRAVEL PACK INTERVALS: From ft. to ft., From ft. to ft., From ft. to ft.

9 GROUT MATERIAL: ☐ Neat cement ☐ Cement grout ☒ Bentonite ☐ Other

Grout Intervals: From ft. to ft., From 4.5 ft. to 5 ft., From ft. to ft.

Nearest source of possible contamination:

☐ Septic Tank

☐ Lateral Lines

☐ Pit Privy

☐ Livestock Pens

☐ Insecticide Storage

☒ Sewer Lines

☐ Cess Pool

☐ Sewage Lagoon

☐ Fuel Storage

☐ Abandoned Water Well

☐ Watertight Sewer Lines

☐ Seepage Pit

☐ Feedyard

☐ Fertilizer Storage

☐ Oil Well/Gas Well

☐ Other (Specify)

Direction from well? East 30' Distance from well? ft.

10 FROM TO LITHOLOGIC LOG FROM TO LITHO. LOG (cont.) or PLUGGING INTERVALS

Notes:

cistern deteriorated did not hold water

11 CONTRACTOR'S OR LANDOWNER'S CERTIFICATION: This water well was ☐ constructed, ☐ reconstructed, or ☒ plugged

under my jurisdiction and was completed on (mo-day-year) 10/25/21 and this record is true to the best of my knowledge and belief.

Kansas Water Well Contractor's License No. This Water Well Record was completed on (mo-day-year) 11/25/21

under the business name of Orlean Const. LLC Signature John D. Orlean

Mail 1 white copy along with a fee of \$5.00 for each constructed well to: Kansas Department of Health and Environment, Bureau of Water, GWTS Section,

1000 SW Jackson St., Suite 420, Topeka, Kansas 66612-1367. Mail one to Water Well Owner and retain one for your records. Telephone 785-296-5524.


Visit us at <http://www.kdheks.gov/waterwell/index.html>

KSA 82a-1212

Revised 7/10/2015

WELL DECOMMISSIONING - 351
Well Plugging Worksheet for an Unconfined AquiferNAME: Admire Methodist Church
LEGAL: 20-16-12
COUNTY: Lyon
IDENT #: _____Design By: GE
Check By: _____Date: 5/3/2021
Date: _____Type of Well: ☒ Drilled ☒ Hand Dug Cistern
Diameter (inside inches): 72 Dia. (outside inches): 84Depth to water: 6.0 ft. Total depth: 8.0 ft.


From 4.5 feet below the ground surface to the ground surface, the plugged well shall be covered with compacted silt, clay soils, or surface soils.

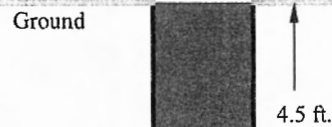

$$\begin{aligned} 38.5 \text{ cu.ft./ft.} \times 4.5 \text{ ft. of fill} &= 173.2 \text{ cu.ft.} \\ 173.2 \text{ cu.ft.} / 27 &= 6.4 \text{ cu. yds.} \end{aligned}$$

PLUG


Place a minimum 0.5-foot thick plug using approved cement or bentonite grout, to the full well diameter after removal of rock lining.

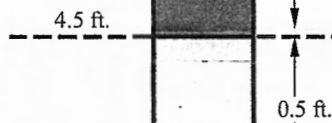


$$\begin{aligned} 38.5 \text{ cuft/ft} \times 0.5 \text{ ft. of plug} &= 19.2 \text{ cu. ft.} \\ 19.2 \text{ cu.ft.} \times 1.36 \text{ bag per cu.ft.} &= 26 \text{ bags of bentonite*} \end{aligned}$$

SUBSOIL

From the static water level to 5 feet below the ground surface, the well shall be filled with compacted clay or an approved grout.

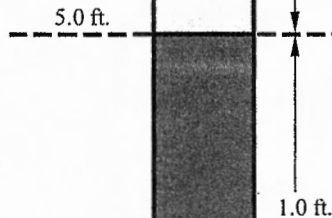

$$\begin{aligned} 28.3 \text{ cuft/ft} \times 1 \text{ ft. of fill} &= 28.3 \text{ cu.ft.} \\ 28.3 \text{ cu.ft.} / 27 &= 1.0 \text{ cu. yds.} \end{aligned}$$

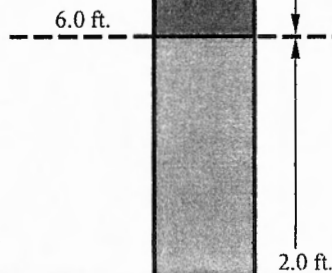Static Water Level

Household chlorine bleach at 5.25 percent concentration of chlorine can be used in a ratio of 1 gallon bleach per 500 gallons of water.

SAND

Fill the well with clean sand or gravel up to the *Static Water Level*.

$$\begin{aligned} 211.5 \text{ gal/ft.} \times 2 \text{ ft water} &= 423.0 \text{ gallons of water} \\ 423.0 / 500 &= 1.0 \text{ gallons of bleach or} \\ 1.00 \text{ gal} \times 128 &= 128 \text{ ounces of bleach} \end{aligned}$$

$$\begin{aligned} 28.3 \text{ cu.ft./ft.} \times 2 \text{ ft. sand} &= 56.5 \text{ cu.ft.} \\ 56.5 \text{ cu.ft.} / 27 &= 2.1 \text{ cu. yds.} \end{aligned}$$

$$\begin{aligned} 2.1 \text{ cu.yds.} + \text{additional } 30\% &= 2.7 \text{ cu. yds. of sand} \\ 2.7 \text{ cu.yds.} \times (1.5 \text{ tons/cu.yd.}) &= 4.1 \text{ tons of sand} \end{aligned}$$

Remove pump, column pipe, and debris. Knock down the top 5 feet of the well rock lining material and let it fall into the well. Prior to starting work, stockpile fill material on site, leaving fill material on a truck or trailer until placed if possible.

* Based on a 50 lb bag of bentonite chips with a unit weight of 68 lb/cf.

RECEIVED**NOV 30 2021****BUREAU OF WATER**


USDA
NRCS

Well Decommissioning - 351

KS-ENG-5P
8/19

Name Admire Methodist Church
Ident. No. 20-16-12
Legal Desc. Lyon
County Lyon
One-Call No. _____

Before any investigation or construction activity, the excavator is responsible for calling Kansas One-Call at 800-344-7233 (800-DIG-SAFE) or 811.

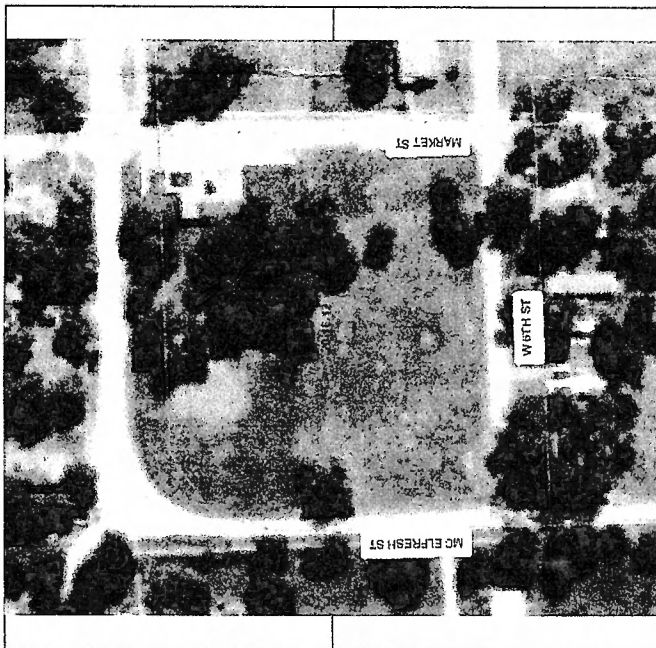

Location Map Scale 1" = _____ fts

Designed by GE Date 5/3/2021

Checked by _____ Date _____

Approved by _____ Date _____

I certify that this installed practice meets NRCS standards and specifications and conforms to the approved drawings.

Checkout by _____ Date _____

Audited by _____ Date _____

Table of Quantities

Item	Unit	Planned or Designed Quantity	Installed Quantity
Total Well Depth	lin. ft.	8.0	
Diameter Plugged	inches	72	
Well Section 1: Top	feet	0.0	
To	feet	4.5	
Fill Material (Soil)	cu. ft.	173.2	
Well Section 2: Well Plug	feet	4.5	
To	feet	5.0	
KDHE Approved Bentonite or Cement Grout	cu. ft.	19.2	
Well Section 3: Subsoil	feet	5.0	
To	feet	6.0	
Fill Material: Native Clay Soils	cu. ft.	28.3	
Well Section 4: Fill Below the Static Waterline	feet	6.0	
To	feet	8.0	
Fill Material (Sand or Gravel)	tons	4.1	
Household Bleach Disinfectant (5.25% solution)	gallons	1.0	

Notes:

Cistern

WELL PLUGGING RECORD. In accordance with Kansas Administrative Regulations (K.A.R.) 28-30-201, file a record of the well plugging with the Kansas Department of Health and Environment (KDHE) office in Topeka, Kansas within 30 days following the completion of the plugging. Use either form WWC-5 or form WWC-5P to record this information.

RECEIVED

NOV 30 2021

BUREAU OF WATER