


1 LOCATION OF WATER WELL: Fraction **SE 1/4 NW 1/4 NW 1/4** Section Number **26** Township Number **T 16 S** Range Number **R 14 E**
 County: **Osage**

Distance and direction from nearest town or city street address of well if located within city?
110 Market St., Osage City, KS

2 WATER WELL OWNER: **Haag Oil Company**
 RR#, St. Address, Box # : **326 SE 15th St** Board of Agriculture, Division of Water Resources
 City, State, ZIP Code : **Topeka, KS 66607** Application Number:

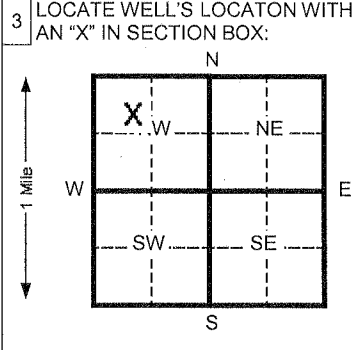

4 DEPTH OF COMPLETED WELL **20** ft. ELEVATION: **1087.26**
 Depth(s) Groundwater Encountered 11.5 **5.5** ft. 2 _____ ft. 3 _____ Ft.
 WELL'S STATIC WATER LEVEL **5.84** ft. below land surface measured on mo/day/yr **03/22/11**
 Pump test data: Well water was _____ Ft. after _____ hours pumping _____ Gpm
 Est. Yield _____ Gpm: Well water was _____ Ft. after _____ Hours pumping _____ Gpm
 Bore Hole Diameter **8.625** in. to **20** ft. and _____ in. to _____ Ft.
 WELL WATER TO BE USED AS: 5 Public water supply 8 Air conditioning 11 Injection well
 1 Domestic 3 Feed lot 6 Oil field water supply 9 Dewatering 12 Other (Specify below)
 2 Irrigation 4 Industrial 7 Lawn and garden (domestic) 10 **Monitoring well** **MW-5**
 Was a chemical/bacteriological sample submitted to Department? Yes _____ No **X** If yes, mo/day/yr sample was Submitted _____ Water Well Disinfected? Yes _____ No **X**

5 TYPE OF BLANK CASING USED: 5 Wrought Iron 8 Concrete tile CASING JOINTS: Glued _____ Clamped _____
 1 Steel 3 RMP (SR) 6 Asbestos-Cement 9 Other (specify below) Welded _____
 2 **PVC** 4 ABS 7 Fiberglass _____ **Threaded** **X**
 Blank casing diameter **2** in. to **5** Ft., Dia _____ in. to _____ ft., Dia _____ in. to _____ ft.
 Casing height above land surface **FLUSH** In., weight **SCH 40** Lbs./ft. Wall thickness or gauge No. _____
 TYPE OF SCREEN OR PERFORATION MATERIAL: 7 **PVC** 10 Asbestos-cement
 1 Steel 3 Stainless steel 5 Fiberglass 8 RMP (SR) 11 Other (specify) _____
 2 Brass 4 Galvanized steel 6 Concrete tile 9 ABS 12 None used (open hole) _____
 SCREEN OR PERFORATION OPENINGS ARE: 5 Gauzed wrapped 8 Saw cut 11 None (open hole)
 1 Continuous slot 3 **Mill slot** 6 Wire wrapped 9 Drilled holes _____
 2 Louvered shutter 4 Key punched 7 Torch cut 10 Other (specify) _____
 SCREEN-PERFORATED INTERVALS: From **5** ft. to **20** ft. From _____ ft. to _____ ft.
 From _____ ft. to _____ ft. From _____ ft. to _____ Ft.
 SAND PACK INTERVALS: From **3** ft. to **20** ft. From _____ ft. to _____ Ft.
 From _____ ft. to _____ ft. From _____ ft. to _____ Ft.

6 GROUT MATERIAL: 1 Neat cement 2 **Cement grout** 3 **Bentonite** 4 Other _____
 Grout intervals From 2 **0.5** ft. to **1** Ft. From 3 **1** to **3** ft. From _____ ft. to _____ ft.
 What is the nearest source of possible contamination:
 1 Septic tank 4 Lateral lines 7 Pit privy 10 Livestock pens 14 Abandoned water well
 2 Sewer lines 5 Cess pool 8 Sewage lagoon 11 Fuel storage 15 Oil well/ Gas well
 3 Watertight sewer lines 6 Seepage pit 9 Feedyard 12 Fertilizer storage 16 **Other (specify below)**
Contaminated Site
 Direction from well? _____ How many feet? _____

FROM	TO	CODE	LITHOLOGIC LOG	FROM	TO	PLUGGING INTERVALS
0	0.5		Grass cover w/ gravel			
0.5	15		Medium brown Clay			
15	20		Reddish brown Clay			
20	TD		End of Borehole			

7 CONTRACTOR'S OR LANDOWNER'S CERTIFICATION: This water well was (x) constructed, (2) reconstructed, or (3) plugged under my jurisdiction and was Completed on (mo/day/yr) **03/22/11** And this record is true to the best of my knowledge and belief. Kansas
 Water Well Contractor's License No. **585** This Water Well Record was completed on (mo/day/yr) **04/13/11**
 under the business name of **Associated Environmental, Inc.** By (signature) **Bradley J. Johnson**
 INSTRUCTIONS: Please fill in blanks and circle the correct answers. Send three copies to Kansas Department of Health and Environment, Bureau of Water, Topeka, Kansas 66620-0001. Telephone: 913-296-5545. Send one to WATER WELL OWNER and retain one for your records.

OFFICE USE ONLY

T
R

SEC