

WATER WELL PLUGGING RECORD Form WWC-5P KSA 82a-1212 ID NO.

MW 3

1 LOCATION OF WATER WELL: Fraction nw ne ne Section Number 5 Township Number T 16 S Range Number 14 E W
 County: Osage sw 1/4 ne 1/4 sw 1/4 1/4


Street/Rural Address of Well Location; if unknown, distance & direction from nearest town or intersection: If at owner's address, check here 8538 West 205th Rd., Osage City, KS

Global Positioning Systems (GPS) information:
 Latitude: 38.693423333 (in decimal degrees)
 Longitude: -95.878329167 (in decimal degrees)
 Elevation: _____
 Horizontal Datum: WGS84, NAD83, NAD27
 Collection Method: _____

AKC K011E

2 WATER WELL OWNER:
 RR#, St. Address, Box #:
 City, State ZIP Code:

GPS unit (Make/Model: Trimble/Geoexplorer 6000)
 Digital Map/Photo, Topographic Map, Land Survey
 Est. Accuracy: < 3 m, 3-5 m, 5-15 m, > 15 m

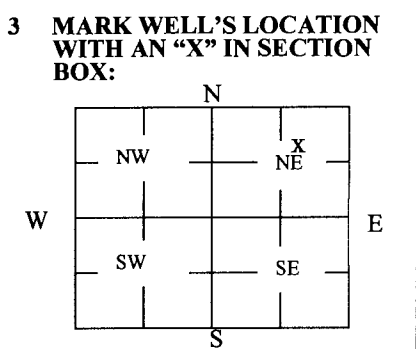

4 DEPTH OF WELL 53.65 ft.
 WELL'S STATIC WATER LEVEL 12.85 ft
 WELL WAS USED AS:
 Domestic Public Water Supply Dewatering
 Irrigation Oil Field Water Supply Monitoring
 Feedlot Domestic (Lawn & Garden) Injection Well
 Industrial Air Conditioning Other _____
 Was a chemical/bacteriological sample submitted to Department? Yes No

5 TYPE OF BLANK CASING USED:
 Steel RMP (SR) Wrought Fiberglass Other (Specify below) _____
 PVC ABS Asbestos-Cement Concrete Tile _____
 Blank casing diameter 2 in. Was casing pulled? Yes No If yes, how much 11.0 ft.
 Casing height above or below land surface 26 above in.

6 GROUT PLUG MATERIAL: Neat cement Cement grout Bentonite Other 3% bentonite grout
 Grout Plug Intervals: From 53.7 ft. to 3.0 ft., From _____ ft. to _____ ft., From _____ ft. to _____ ft.
 What is the nearest source of possible contamination:
 Septic tank Seepage pit Fuel storage Other (specify below) _____
 Sewer lines Pit privy Fertilizer storage formerly used defense site
 Watertight sewer lines Sewage lagoon Insecticide storage _____
 Lateral lines Feedyard Abandoned water well _____
 Cess pool Livestock pens Oil well/Gas well _____
 Direction from well? _____
 How many feet? _____

FROM	TO	PLUGGING MATERIALS	FROM	TO	PLUGGING MATERIALS
0	3	native soil			
3	53.7	3% bentonite cement grout			

7 CONTRACTOR'S OR LANDOWNER'S CERTIFICATION: This water well was plugged under my jurisdiction and was completed on (mo/day/year) 09/14/2016 and this record is true to the best of my knowledge and belief. Kansas Water Well Contractor's License No. _____. This Water Well Record was completed on (mo/day/year) 09/15/2016 under the business name of US Army Corps of Engineers by (signature) _____

Send one white copy to Kansas Department of Health & Environment, Geology Section, 1000 SW Jackson Street, Ste. 420, Topeka, KS 66612-1367. Send one copy to WATER WELL OWNER and retain one for your records.
 Visit us at <http://www.kdheks.gov/waterwell/index.html> Telephone 785-296-5524.