

WATER WELL PLUGGING RECORD Form WWC-5P KSA 82a-1212 ID NO.

MW 6


1 LOCATION OF WATER WELL: County: <u>Osage</u>	Fraction <u>ne 1/4 nw 1/4 ne 1/4 1/4</u>	Section Number <u>5</u>	Township Number <u>T 16 S</u>	Range Number <u>14</u> <input checked="" type="checkbox"/> E <input type="checkbox"/> W
--	---	----------------------------	----------------------------------	--

Street/Rural Address of Well Location; if unknown, distance & direction from nearest town or intersection: If at owner's address, check here 8538 West 205th Rd., Osage City, KS

Global Positioning Systems (GPS) information:
 Latitude: 38.694631944 (in decimal degrees)
 Longitude: -95.880985833 (in decimal degrees)
 Elevation: _____
 Horizontal Datum: WGS84, NAD83, NAD27
 Collection Method: _____

2 WATER WELL OWNER:
 RR#, St. Address, Box #:
 City, State ZIP Code:

GPS unit (Make/Model: Trimble/Geoploter 6000)
 Digital Map/Photo, Topographic Map, Land Survey
 Est. Accuracy: < 3 m, 3-5 m, 5-15 m, > 15 m

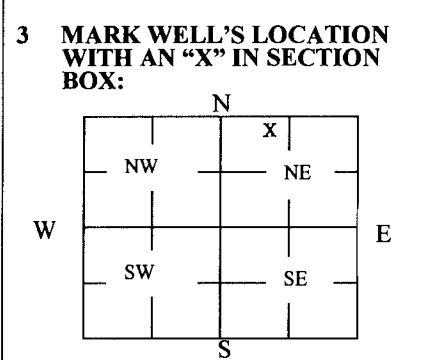

4 DEPTH OF WELL 84.75 **ft.**
 WELL'S STATIC WATER LEVEL 42.65 **ft.**
 WELL WAS USED AS:
 Domestic Public Water Supply Dewatering
 Irrigation Oil Field Water Supply Monitoring
 Feedlot Domestic (Lawn & Garden) Injection Well
 Industrial Air Conditioning Other _____
 Was a chemical/bacteriological sample submitted to Department? Yes No

5 TYPE OF BLANK CASING USED:

Steel RMP (SR) Wrought Fiberglass Other (Specify below)
 PVC ABS Asbestos-Cement Concrete Tile _____

Blank casing diameter 2 in. Was casing pulled? Yes No If yes, how much 17.8 ft.
 Casing height above or below land surface 33 above in.

6 GROUT PLUG MATERIAL: Neat cement Cement grout Bentonite Other 3% bentonite grout

Grout Plug Intervals: From 84.8 ft. to 3.0 ft., From _____ ft. to _____ ft., From _____ ft. to _____ ft.

What is the nearest source of possible contamination:
 Septic tank Seepage pit Fuel storage Other (specify below) _____
 Sewer lines Pit privy Fertilizer storage formerly used defense site
 Watertight sewer lines Sewage lagoon Insecticide storage
 Lateral lines Feedyard Abandoned water well Direction from well? _____
 Cess pool Livestock pens Oil well/Gas well How many feet? _____

FROM	TO	PLUGGING MATERIALS	FROM	TO	PLUGGING MATERIALS
0	3	native soil			
3	84.8	3% bentonite cement grout			

7 CONTRACTOR'S OR LANDOWNER'S CERTIFICATION: This water well was plugged under my jurisdiction and was completed on (mo/day/year) 09/13/2016 and this record is true to the best of my knowledge and belief. Kansas Water Well Contractor's License No. _____. This Water Well Record was completed on (mo/day/year) 09/15/2016 under the business name of US Army Corps of Engineers by (signature) _____