


1 LOCATION OF WATER WELL: County: **OSAGE** Fraction: **NW 1/4 SW 1/4 SE 1/4** Section Number: **17** Township Number: **T 16 S** Range Number: **R 15 EW**

Distance and direction from nearest town or city street address of well if located within city?
APROX 2M-E-1M-N-1/2E OF OSAGE CITY

2 WATER WELL OWNER: **OSAGE CO.**
 RR#, St. Address, Box #: **P.O. BOX 726** Board of Agriculture, Division of Water Resources
 City, State, ZIP Code: **LYNDON KS 66451** Application Number:

3 LOCATE WELL'S LOCATION WITH AN "X" IN SECTION BOX:

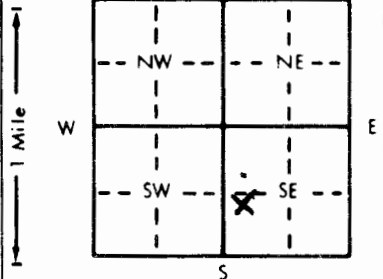

4 DEPTH OF COMPLETED WELL: **20** ft. ELEVATION: **1108.45**
 Depth(s) Groundwater Encountered: **15** ft. 2. — ft. 3. — ft.
 WELL'S STATIC WATER LEVEL: **5.89** ft. below land surface measured on mo/day/yr
 Pump test data: Well water was — ft. after — hours pumping — gpm
 Est. Yield — gpm Well water was — ft. after — hours pumping — gpm
 Bore Hole Diameter: **8 3/8** in. to **20** ft., and — in. to — ft.
 WELL WATER TO BE USED AS:
 5 Public water supply 8 Air conditioning 11 Injection well
 1 Domestic 3 Feedlot 6 Oil field water supply 9 Dewatering 12 Other (Specify below)
 2 Irrigation 4 Industrial 7 Lawn and garden only 10 Monitoring well
 Was a chemical/bacteriological sample submitted to Department? Yes — No **X**; If yes, mo/day/yr sample was submitted —
 Water Well Disinfected? Yes — No **X**

5 TYPE OF BLANK CASING USED:
 1 Steel 3 RMP (SR) 5 Wrought iron 8 Concrete tile CASING JOINTS: Glued — Clamped —
 2 PVC 4 ABS 6 Asbestos-Cement 9 Other (specify below) Welded —
 7 Fiberglass Threaded **X**
 Blank casing diameter: **4** in. to **10** ft., Dia — in. to — ft. Dia — in. to — ft.
 Casing height above land surface: **26** in., weight **SCH 40** lbs./ft. Wall thickness or gauge No. —

TYPE OF SCREEN OR PERFORATION MATERIAL:
 1 Steel 3 Stainless steel 5 Fiberglass 7 PVC 10 Asbestos-cement
 2 Brass 4 Galvanized steel 6 Concrete tile 8 RMP (SR) 11 Other (specify) —
 12 None used (open hole)

SCREEN OR PERFORATION OPENINGS ARE:
 1 Continuous slot 3 Mill slot 5 Gauzed wrapped 8 Saw cut 11 None (open hole)
 2 Louvered shutter 4 Key punched 7 Torch cut 9 Drilled holes
 10 Other (specify) —

SCREEN-PERFORATED INTERVALS: From **10** ft. to **20** ft., From — ft. to — ft.
SAND From — ft. to — ft., From — ft. to — ft.
~~GRAVEL~~ PACK INTERVALS: From **8** ft. to **20** ft., From — ft. to — ft.
 From — ft. to — ft., From — ft. to — ft.

6 GROUT MATERIAL: 1 Neat cement 2 Cement grout 3 Bentonite 4 Other —
 Grout Intervals: From **3** ft. to **5.5** ft., From **8** ft. to **20** ft., From **20** ft. to **5.5** ft., From — ft. to — ft.

What is the nearest source of possible contamination:
 1 Septic tank 4 Lateral lines 7 Pit privy 10 Livestock pens 14 Abandoned water well
 2 Sewer lines 5 Cess pool 8 Sewage lagoon 11 Fuel storage 15 Oil well/Gas well
 3 Watertight sewer lines 6 Seepage pit 9 Feedyard 12 Fertilizer storage 16 Other (specify below)
LAND FILL

Direction from well? — How many feet? —

FROM	TO	LITHOLOGIC LOG	FROM	TO	PLUGGING INTERVALS
0L	1	SDIL			
1	5	SILTY CLAY			
5	12	SHALE BLUE-GRAY			
12	14	SHALE - GRAY			
14	15	LIME - SILT STONE			
15	17	LIMESTONE			
17	20	SHALE - GRAY			
TD	20				

7 CONTRACTOR'S OR LANDOWNER'S CERTIFICATION: This water well was **(1)** constructed, **(2)** reconstructed, or **(3)** plugged under my jurisdiction and was completed on (mo/day/year) **04-21-94** and this record is true to the best of my knowledge and belief. Kansas Water Well Contractor's License No. **479** This Water Well Record was completed on (mo/day/yr) **05-16-94** under the business name of **EBBERTS DRILLING** by (signature) *Morgan Ebberts*

OFFICE USE ONLY
T
R
EW
SEC.