


1 LOCATION OF WATER WELL: County: OSAGE	Fraction SE 1/4 SE 1/4 NE 1/4	Section Number 2	Township Number T 16 S	Range Number R 16 E/W
--	----------------------------------	---------------------	---------------------------	---------------------------------

Distance and direction from nearest town or city street address of well if located within city?

3/4 north, 4 west of Michigan Valley

2 WATER WELL OWNER: Kevin Welsch
 RR#, St. Address, Box #: 20643 South Cedar Rd.
 City, State, ZIP Code: Overbrook, KS 66524-9154
 Board of Agriculture, Division of Water Resources
 Application Number:

3 LOCATE WELL'S LOCATION WITH AN "X" IN SECTION BOX:

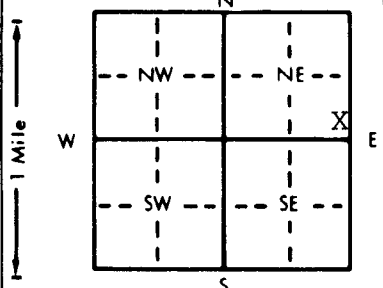

4 DEPTH OF COMPLETED WELL: 120' ft. ELEVATION:
 Depth(s) Groundwater Encountered 1. 75' ft. 2. ft. 3. ft.
 WELL'S STATIC WATER LEVEL .54' ft. below land surface measured on mo/day/yr 8/6/96
 Pump test data: Well water was ft. after hours pumping gpm
 Est. Yield 1/2 gpm: Well water was ft. after hours pumping gpm
 Bore Hole Diameter: 8 3/4 in. to ft., and in. to ft.
 WELL WATER TO BE USED AS:
 1 Domestic 3 Feedlot 6 Oil field water supply 9 Dewatering 11 Injection well
 2 Irrigation 4 Industrial 7 Lawn and garden only 10 Monitoring well 12 Other (Specify below)
 Was a chemical/bacteriological sample submitted to Department? Yes No **X** If yes, mo/day/yr sample was submitted
 Water Well Disinfected? Yes **X** No

5 TYPE OF BLANK CASING USED:
 1 Steel 3 RMP (SR) 5 Wrought iron 8 Concrete tile CASING JOINTS: Glued **X** Clamped
 2 PVC 4 ABS 6 Asbestos-Cement 9 Other (specify below) Welded
 7 Fiberglass Threaded

Blank casing diameter 5" in. to 0-60 ft., Dia 5" in. to 80-119 ft., Dia in. to ft.
 Casing height above land surface 24" in., weight 2.82 lbs./ft. Wall thickness or gauge No. 258

TYPE OF SCREEN OR PERFORATION MATERIAL:
 1 Steel 3 Stainless steel 5 Fiberglass 7 PVC 10 Asbestos-cement
 2 Brass 4 Galvanized steel 6 Concrete tile 8 RMP (SR) 11 Other (specify)
 12 None used (open hole)

SCREEN OR PERFORATION OPENINGS ARE:
 1 Continuous slot 3 Mill slot 5 Gauzed wrapped 8 Saw cut 11 None (open hole)
 2 Louvered shutter 4 Key punched 6 Wire wrapped 9 Drilled holes
 7 Torch cut 10 Other (specify)

SCREEN-PERFORATED INTERVALS: From 60 ft. to 80 ft., From ft. to ft.
 From 119 ft. to 120 ft., From ft. to ft.
 GRAVEL PACK INTERVALS: From 24 ft. to 120 ft., From ft. to ft.
 From ft. to ft., From ft. to ft.

6 GROUT MATERIAL: 1 Neat cement 2 Cement grout 3 Bentonite 4 Other
 Grout Intervals: From 4 ft. to 24 ft., From ft. to ft., From ft. to ft.

What is the nearest source of possible contamination:
 1 Septic tank 4 Lateral lines 7 Pit privy 10 Livestock pens 14 Abandoned water well
 2 Sewer lines 5 Cess pool 8 Sewage lagoon 11 Fuel storage 15 Oil well/Gas well
 3 Watertight sewer lines 6 Seepage pit 9 Feedyard 12 Fertilizer storage 16 Other (specify below)
 13 Insecticide storage
 Direction from well? west How many feet? 100'

FROM	TO	LITHOLOGIC LOG	FROM	TO	PLUGGING INTERVALS
0	6	Clay-Brown	80	94	Shale-Grey
6	10	Limestone-Yellow	94	114	Limestone-Grey
10	12	Shale-Yellow	114	120	Shale-Grey
12	13	Shale-Black			
13	16	Limestone-Grey			
16	20	Shale-Grey			
20	22	Limestone-Tan			
22	23	Shale-Grey			
23	27	Limestone-Tan			
27	28	Shale-Grey			
28	34	Limestone-Tan			
34	57	Shale-Grey			
57	62	Limestone-Grey			
62	72	Shale-Grey			
72	80	Sandstone-Grey			

7 CONTRACTOR'S OR LANDOWNER'S CERTIFICATION: This water well was (1) constructed, (2) reconstructed, or (3) plugged under my jurisdiction and was completed on (mo/day/year) 8/6/96 and this record is true to the best of my knowledge and belief. Kansas Water Well Contractor's License No. 182 This Water Well Record was completed on (mo/day/yr) 8-22-96 under the business name of STRADER DRILLING CO., INC. by (signature) Dale Askren