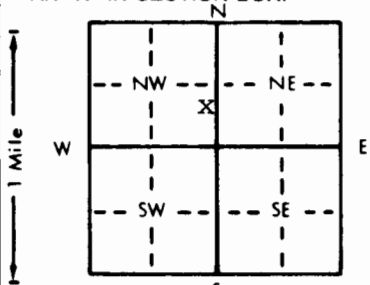


1 LOCATION OF WATER WELL:		Fraction	Section Number	Township Number	Range Number
County: OSAGE		NE 1/4 SE 1/4 NW 1/4	31	T 16 S	R 16 EW
Distance and direction from nearest town or city street address of well if located within city? 1320 N TOPEKA AVE LYNDON, KS					
2 WATER WELL OWNER: TAYLOR OIL CO.					
RR#, St. Address, Box # : P.O. BOX 518 LYNDON, KS 66451				Board of Agriculture, Division of Water Resources	
City, State, ZIP Code :				Application Number:	
3 LOCATE WELL'S LOCATION WITH AN "X" IN SECTION BOX:		4 DEPTH OF COMPLETED WELL: 16 ft. ELEVATION:			
		Depth(s) Groundwater Encountered 1. . . . . ft. 2. . . . . ft. 3. . . . . ft.			
		WELL'S STATIC WATER LEVEL . . . . . ft. below land surface measured on mo/day/yr			
		Pump test data: Well water was . . . . . ft. after . . . . . hours pumping . . . . . gpm			
		Est. Yield . . . . . gpm: Well water was . . . . . ft. after . . . . . hours pumping . . . . . gpm			
		Bore Hole Diameter: 7 1/4 in. to 16 in. and . . . . . in. to . . . . . ft.			
		WELL WATER TO BE USED AS:			
		5 Public water supply 8 Air conditioning 11 Injection well			
		1 Domestic 3 Feedlot 6 Oil field water supply 9 Dewatering 12 Other (Specify below)			
		2 Irrigation 4 Industrial 7 Lawn and garden only 10 Monitoring well X			
		Was a chemical/bacteriological sample submitted to Department? Yes . . . . . No . . . . . ; If yes, mo/day/yr sample was submitted			
		Water Well Disinfected? Yes . . . . . No . . . . .			
5 TYPE OF BLANK CASING USED:					
1 Steel 3 RMP (SR) 5 Wrought iron 8 Concrete tile CASING JOINTS: Glued . . . . . Clamped . . . . .					
2 PVC X 4 ABS 6 Asbestos-Cement 9 Other (specify below) Welded . . . . .					
7 Fiberglass Threaded . . . . .					
Blank casing diameter . . . . . 2 in. to 6 in. Dia . . . . . in. to . . . . . ft. Dia . . . . . in. to . . . . . ft.					
Casing height above land surface . . . . . 0 in., weight . . . . . lbs./ft. Wall thickness or gauge No. . . . .					
TYPE OF SCREEN OR PERFORATION MATERIAL:					
1 Steel 3 Stainless steel 5 Fiberglass 8 RMP (SR) 10 Asbestos-cement					
2 Brass 4 Galvanized steel 6 Concrete tile 9 ABS 11 Other (specify) . . . . .					
12 None used (open hole)					
SCREEN OR PERFORATION OPENINGS ARE:					
1 Continuous slot 3 Mill slot .010 5 Gauzed wrapped 8 Saw cut 11 None (open hole)					
2 Louvered shutter 4 Key punched 6 Wire wrapped 9 Drilled holes					
7 Torch cut 10 Other (specify) . . . . .					
SCREEN-PERFORATED INTERVALS: From . . . . . 16 ft. to . . . . . 6 ft., From . . . . . ft. to . . . . . ft.					
From . . . . . ft. to . . . . . ft., From . . . . . ft. to . . . . . ft.					
GRAVEL PACK INTERVALS: From . . . . . 16 ft. to . . . . . 4.5 ft., From . . . . . ft. to . . . . . ft.					
From . . . . . ft. to . . . . . ft., From . . . . . ft. to . . . . . ft.					
6 GROUT MATERIAL: 1 Neat cement X 2 Cement grout 3 Bentonite 4 Other . . . . .					
Grout Intervals: From . . . . . 3 ft. to surface ft., From . . . . . 4.5 ft. to 3 ft., From . . . . . ft. to . . . . . ft.					
What is the nearest source of possible contamination:					
1 Septic tank 4 Lateral lines 7 Pit privy X 1 Fuel storage 14 Abandoned water well					
2 Sewer lines 5 Cess pool 8 Sewage lagoon 12 Fertilizer storage 15 Oil well/Gas well					
3 Watertight sewer lines 6 Seepage pit 9 Feedyard 13 Insecticide storage 16 Other (specify below)					
Direction from well? west How many feet? 65'					
FROM TO LITHOLOGIC LOG FROM TO PLUGGING INTERVALS					
0 6" concrete					
0.6 5 BRN STIFF CLAY					
5 10 VERY WEATHERED BRN TAN CLAY					
10 15.5 SHALE GREEN GRAY					
15.5 16 LIMESTONE					
7 CONTRACTOR'S OR LANDOWNER'S CERTIFICATION: This water well was (1) constructed, (2) reconstructed, or (3) plugged under my jurisdiction and was completed on (mo/day/year) 3-4-97 and this record is true to the best of my knowledge and belief. Kansas					
Water Well Contractor's License No. 575 This Water Well Record was completed on (mo/day/yr) 3-4-97					
under the business name of KURTZ ENVIRONMENTAL SERVICE by (signature)					