


1 LOCATION OF WATER WELL: Fraction NE 1/4 SE 1/4 NW 1/4 Section Number 31 Township Number T 16 S Range Number R 16 EW  
 County: OSAGE

Distance and direction from nearest town or city street address of well if located within city?  
 1320 N TOPEKA AVE LYNDON KS

2 WATER WELL OWNER: TAYLOR OIL CO.  
 RR#, St. Address, Box #: P.O. BOX 518 LYNDON KS 66451  
 City, State, ZIP Code: Board of Agriculture, Division of Water Resources  
 Application Number:

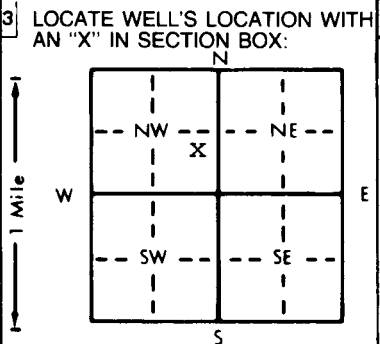

4 DEPTH OF COMPLETED WELL: 1.6 ft. ELEVATION:  
 Depth(s) Groundwater Encountered 1. ft. 2. ft. 3. ft.  
 WELL'S STATIC WATER LEVEL ft. below land surface measured on mo/day/yr  
 Pump test data: Well water was ft. after hours pumping gpm  
 Est. Yield gpm: Well water was ft. after hours pumping gpm  
 Bore Hole Diameter: 7 1/4 in. to 1.6 ft., and in. to ft.  
 WELL WATER TO BE USED AS:  
 5 Public water supply 8 Air conditioning 11 Injection well  
 1 Domestic 3 Feedlot 6 Oil field water supply 9 Dewatering 12 Other (Specify below)  
 2 Irrigation 4 Industrial 7 Lawn and garden only X0 Monitoring well  
 Was a chemical/bacteriological sample submitted to Department? Yes No; If yes, mo/day/yr sample was submitted  
 Water Well Disinfected? Yes No

5 TYPE OF BLANK CASING USED:  
 1 Steel 3 RMP (SR) 5 Wrought iron 8 Concrete tile CASING JOINTS: Glued Clamped  
 2 PVC X 4 ABS 6 Asbestos-Cement 9 Other (specify below) Welded  
 7 Fiberglass X Threaded  
 Blank casing diameter 2.0 in. to 6 ft., Dia in. to ft., Dia in. to ft.  
 Casing height above land surface 0 in., weight sched. 40 PVC lbs./ft. Wall thickness or gauge No.  
 TYPE OF SCREEN OR PERFORATION MATERIAL:  
 1 Steel 3 Stainless steel 5 Fiberglass 8 RMP (SR) 10 Asbestos-cement  
 2 Brass 4 Galvanized steel 6 Concrete tile 9 ABS 11 Other (specify)  
 12 None used (open hole)  
 SCREEN OR PERFORATION OPENINGS ARE:  
 1 Continuous slot 3 Mill slot 010 6 Wire wrapped 8 Saw cut 11 None (open hole)  
 2 Louvered shutter 4 Key punched 7 Torch cut 10 Other (specify)  
 SCREEN-PERFORATED INTERVALS: From 1.6 ft. to 6 ft., From ft. to ft.  
 From ft. to ft., From ft. to ft.  
 GRAVEL PACK INTERVALS: From 1.6 ft. to 4 ft., From ft. to ft.  
 From ft. to ft., From ft. to ft.

6 GROUT MATERIAL: 2 1 Neat cement X 2 Cement grout 4 X 3 Bentonite 4 Other  
 Grout Intervals: From 2 ft. to surface ft., From 4 ft. to 2 ft., From ft. to ft.  
 What is the nearest source of possible contamination:  
 1 Septic tank 4 Lateral lines 7 Pit privy 10 Livestock pens 14 Abandoned water well  
 2 Sewer lines X 5 Cess pool 8 Sewage lagoon 11 Fuel storage 15 Oil well/Gas well  
 3 Watertight sewer lines 6 Seepage pit 9 Feedyard 12 Fertilizer storage 16 Other (specify below)  
 13 Insecticide storage  
 Direction from well? S/E How many feet? 16'

| FROM | TO | LITHOLOGIC LOG         | FROM | TO | PLUGGING INTERVALS |
|------|----|------------------------|------|----|--------------------|
| 0    | 3  | topsoil                |      |    |                    |
| 3    | 10 | BRN STIFF CLAY         |      |    |                    |
| 10   | 16 | DARK BRN TO GRAY SHALE |      |    |                    |
|      |    |                        |      |    |                    |
|      |    |                        |      |    |                    |
7 CONTRACTOR'S OR LANDOWNER'S CERTIFICATION: This water well was (1) constructed, (2) reconstructed, or (3) plugged under my jurisdiction and was completed on (mo/day/year) 3-6-97 and this record is true to the best of my knowledge and belief. Kansas Water Well Contractor's License No. 575 This Water Well Record was completed on (mo/day/year) 3-19-97 under the business name of KURTZ ENVIRONMENTAL SERVICE by (signature)

OFFICE USE ONLY  
 T  
 R  
 EW  
 SEC.