

USE TYPEWRITER OR BALL POINT PEN-PRESS FIRMLY, PRINT CLEARLY.


T R EW sec 1/4 1/4 1/4 No.

WATER WELL RECORD  
KSA 82a-1201-1215

Kansas State Dept. Of Health  
(Water Well Contractors)  
Forbes-Bldg. 740  
Topeka, Kansas 66620

1 Location of well: County Osage Township name ~~Atch~~ Fraction NW 1/4 NE 1/4 Section number 11 Town number 16 S Range number 16 E

Distance and direction from nearest town or city: 1/2 m. North of Vassar 3 Owner of well: W. H. Hansen  
Street address of well location if in city: Address: R R #1 Box 201 Basehor, KS 66007

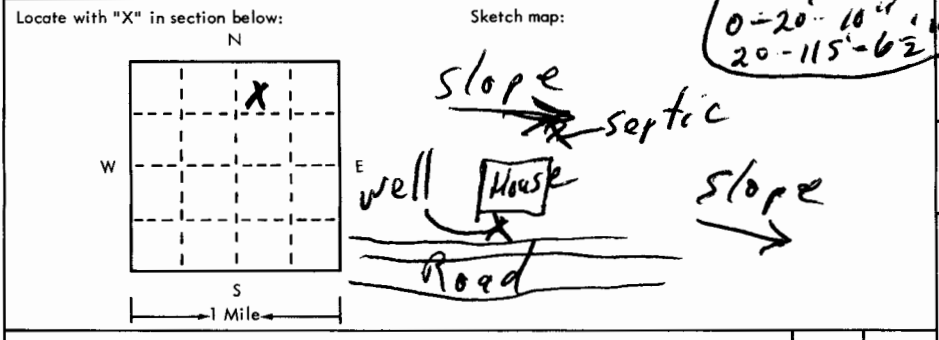

4 Well depth: 115 ft. Date of completion 4/19/76  
Well diameter 10 1/4 in.

5  Cable tool  Rotary  Driven  Dug  
 Hollow rod  Jetted  Bored  Reverse rotary

6 Use:  Domestic  Public supply  Industry  
 Irrigation  Air conditioning  Commercial  
 Test well

7 Casing: Material PITS Height: above/below  
Threaded  Welded  Surface 12  
Diam. 5 in. to 115 ft. depth Drive shoe?  Yes  No  
5 in. to 115 ft. depth

2	Type and color of material	From	To
	Clay yellow	0	16
	lime	16	20
	Clay yellow + Broken lime	20	30
	lime grey	30	35
	shale sticky grey	35	40
	lime grey hard	40	45
	shale grey	45	47
	lime light grey	47	62
	shale dark grey	62	82
	Shale + sandstone in spots grey	82	115

8 Screen: Manufacturer Jess + Lowell 200  
Type RMP Dia. 5"  
Slot/gauze 3/16 Length 75  
Set between 3/40 ft. and 115 ft.  
Fittings: Gravel pack  Yes  No Size range of material

9 Static water level: 57 ft. below land surface Date 4/19/76

10 Pumping level below land surfaces:  
\_\_\_\_ ft. after \_\_\_\_ hrs. pumping \_\_\_\_ g.p.m.  
\_\_\_\_ ft. after \_\_\_\_ hrs. pumping \_\_\_\_ g.p.m.  
Estimated maximum yield 3/4 g.p.m.

11 Water sample submitted:  
 Yes  No Date

12 Well head completion:  
 Pitless adapter 12 inches above grade

13 Well grouted?  Yes  No  
 Neat cement  Bentonite   
Depth: From 0 ft. to 25 ft.

14 Nearest source of possible contamination:  
ft. 000 Direction North Type septic  
Well disinfected upon completion?  Yes  No

15 Pump:  Not installed  
Manufacturer's name \_\_\_\_\_  
Model number \_\_\_\_\_ HP \_\_\_\_\_ Volts \_\_\_\_\_  
Length of drop pipe \_\_\_\_\_ ft. capacity \_\_\_\_\_ g.m.p.  
Type:  
 Submersible  Turbine  
 Jet  Reciprocating  
 Centrifugal  Other

16 Remarks: elevation  
Topography:  Hill  Slope  Upland  Valley  
Concrete slab to be installed by owner.

17 Water well contractor's certification:  
This well was drilled under my jurisdiction and this report is true to the best of my knowledge and belief.  
Robison Drilling 316A  
Business name \_\_\_\_\_ License No. \_\_\_\_\_  
Address Perry KS  
Signed \_\_\_\_\_ Date 4/19/76

16 16 E 11 NUNE