

WATER WELL RECORD

Form WWC-5


Division of Water Resources App. No.

1 LOCATION OF WATER WELL: County: OSAGE	Fraction NE 1/4 SE 1/4 NE 1/4 NW 1/4	Section Number 21	Township No. T 16 S	Range Number R 76 <input checked="" type="checkbox"/> E <input type="checkbox"/> W
--	--	-----------------------------	-------------------------------	--

Street/Rural Address of Well Location; if unknown, distance & direction from nearest town or intersection: If at owner's address, check here .

Global Positioning System (GPS) information:
 Latitude: **38.6520014** (in decimal degrees)
 Longitude: **-95.656298** (in decimal degrees)
 Elevation: _____
 Datum: WGS 84, NAD 83, NAD 27
 Collection Method:
 GPS unit (Make/Model: _____)
 Digital Map/Photo, Topographic Map, Land Survey
 Est. Accuracy: <3 m, 3-5 m, 5-15 m, >15 m

2 WATER WELL OWNER: **DELBERT RAMSEY**
 RR#, Street Address, Box #: **1717 E. 229TH STREET**
 City, State, ZIP Code : **LYNDON, KS 66451**

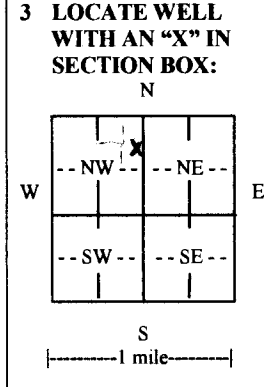

4 DEPTH OF COMPLETED WELL **250** ft.

Depth(s) Groundwater Encountered (1) **NONE** ft. (2) _____ ft. (3) _____ ft.

WELL'S STATIC WATER LEVEL _____ ft. below land surface measured on mo/day/yr _____

Pump test data: Well water was _____ ft. after _____ hours pumping _____ gpm

EST. YIELD **0** gpm. Well water was _____ ft. after _____ hours pumping _____ gpm

Bore Hole Diameter **5 5/8** in. to _____ ft., and _____ in. to _____ ft.

WELL WATER TO BE USED AS: Public water supply Geothermal Injection well
 Domestic Feedlot Oil field water supply Dewatering Other (Specify below)
 Irrigation Industrial Domestic-lawn & garden Monitoring well **CLOSED LOOP**

Was a chemical/bacteriological sample submitted to Department? Yes No
 If yes, mo/day/yr sample was submitted _____

Water well disinfected? Yes No

5 TYPE OF CASING USED: Steel PVC Other **HD POLYETHYLENE**

CASING JOINTS: Glued Clamped Welded Threaded

Casing diameter **3/4** in. to **250** ft., Diameter _____ in. to _____ ft., Diameter _____ in. to _____ ft.
 Casing height above land surface **36** in., Weight **SDR11** lbs./ft., Wall thickness or gauge No. **160PSI**

TYPE OF SCREEN OR PERFORATION MATERIAL:
 Steel Stainless Steel PVC Other (Specify) _____
 Brass Galvanized Steel None used (open hole)

SCREEN OR PERFORATION OPENINGS ARE:
 Continuous slot Mill slot Gauze wrapped Torch cut Drilled holes None (open hole)
 Louvered shutter Key punched Wire wrapped Saw cut Other (specify) _____

SCREEN-PERFORATED INTERVALS: From _____ ft. to _____ ft., From _____ ft. to _____ ft.
 From _____ ft. to _____ ft., From _____ ft. to _____ ft.

GRAVEL PACK INTERVALS: From _____ ft. to _____ ft., From _____ ft. to _____ ft.
 From _____ ft. to _____ ft., From _____ ft. to _____ ft.

6 GROUT MATERIAL: Neat cement Cement grout Bentonite Other _____

Grout Intervals: From **3** ft. to **250** ft., From _____ ft. to _____ ft., From _____ ft. to _____ ft.

What is the nearest source of possible contamination:
 Septic tank Lateral lines Pit privy Livestock pens Insecticide storage Other (specify below)
 Sewer lines Cesspool Sewage lagoon Fuel storage Abandoned water well
 Watertight sewer lines Seepage pit Feedyard Fertilizer storage Oil well/gas well _____

Direction from well _____ Distance from well _____

FROM	TO	LITHOLOGIC LOG		FROM	TO	LITHO. LOG (cont.) or PLUGGING INTERVALS
0	3	SOIL/CLAY	121-126 LIME			
3	14	SANDSTONE	126-163 SHALE			
14	20	LIME	126-163 SHALE			
20	57	SHALE	163-172 LIME			
57	70	LIME	172-184 SHALE	250	3	3-250' BORES PLUGGED WITH
70	73	SHALE	184-206 LIME			HIGH SOLID BENTONITE
73	98	LIME	206-225 SHALE			
98	101	SHALE	225-238 LIME			
101	108	LIME	238-250 SHALE			
108	121	SHALE				

7 CONTRACTOR'S OR LANDOWNER'S CERTIFICATION: This water well was constructed, reconstructed, or plugged under my jurisdiction and was completed on (mo/day/year) **03/13/2015**... and this record is true to the best of my knowledge and belief. Kansas Water Well Contractor's License No. **561**... This Water Well Record was completed on (mo/day/year) **03/16/2015** under the business name of **EVANS ENERGY DEVELOPMENT, INC.** by (signature) *[Signature]*

INSTRUCTIONS: Use typewriter or ball point pen. **PLEASE PRESS FIRMLY** and **PRINT** clearly. Please fill in blanks and check the correct answers. Send one copy to Kansas Department of Health and Environment, Bureau of Water, Geology Section, 1000 SW Jackson St., Suite 420, Topeka, Kansas 66612-1367. Telephone 785-296-5524. Send one copy to WATER WELL OWNER and retain one for your records. Include fee of \$5.00 for each constructed well. Visit us at <http://www.kdheks.gov/waterwell/index.html>