

WATER WELL PLUGGING RECORD Form WWC-5P

KSA 82a-1212 ID NO.

1 LOCATION OF WATER WELL: County: OSAGE Fraction NW 1/4 NW 1/4 SW 1/4 Section Number 29 Township Number 16 Range Number 16


Distance and direction from nearest town or city street address of well if located within city?

1/2 mile North of Lydon, on East Side

2 WATER WELL OWNER: DANA ORTIZ
RR#, St. Address, Box #: 24236 South
City, State ZIP Code: Lydon, KS 66451

Global Positioning Systems (decimal degrees, min. of 4 digits)
Latitude: _____
Longitude: _____
Elevation: _____
Datum: _____
Data Collection Method: _____

3 MARK WELL'S LOCATION WITH AN "X" IN SECTION BOX:

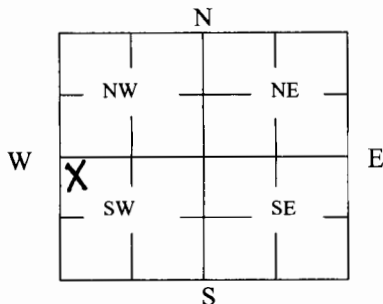

4 DEPTH OF WELL 12 ft.

WELL'S STATIC WATER LEVEL 10' ft

WELL WAS USED AS:

- ☒ Domestic
2 Irrigation
3 Feedlot
4 Industrial
5 Public Water Supply
6 Oil Field Water Supply
7 Domestic (Lawn & Garden)
8 Air Conditioning
9 Dewatering
10 Monitoring
11 Injection Well
12 Other _____

Was a chemical/bacteriological sample submitted to Department? Yes _____ No ☒

5 TYPE OF BLANK CASING USED:

- 1 Steel 3 RMP (SR) 5 Wrought 7 Fiberglass 9 Other (Specify below)
2 PVC 4 ABS 6 Asbestos-Cement 8 Concrete Tile

Blank casing diameter 4 FT. Was casing pulled? Yes _____ No ☒ If yes, how much _____
Casing height above or below land surface 4 FT.

6 GROUT PLUG MATERIAL: ☒ Neat cement 2 Cement grout ☒ Bentonite 4 Other _____

Grout Plug Intervals: From 12 ft. to 9 ft., From 6 ft. to 4 ft., From _____ to _____ ft.

What is the nearest source of possible contamination:

- 1 Septic tank 6 Seepage pit 11 Fuel Storage 16 Other (specify below) House
2 Sewer lines 7 Pit privy 12 Fertilizer storage
3 Watertight sewer lines 8 Sewage lagoon 13 Insecticide storage
4 Lateral lines 9 Feedyard 14 Abandoned water well Direction from well? N.E.
5 Cess pool 10 Livestock pens 15 Oil well/Gas well How many feet? 15 FT

FROM	TO	PLUGGING MATERIALS	FROM	TO	PLUGGING MATERIALS
12	9	Bentonite	4	0	Top Soil
9	6	Rock lining			
6	4	Neat Cement			

7 CONTRACTOR'S OR LANDOWNER'S CERTIFICATION: This water well was plugged under my jurisdiction and was completed on (mo/day/year) 3-20-17 and this record is true to the best of my knowledge and belief. Kansas Water Well Contractor's License No. 536. This Water Well Record was completed on (mo/day/year) 3-24-17 under the business name of Patchen Pump & Well Drilling, Inc by (signature) Tom E. Patchen

INSTRUCTIONS: Use typewriter or ballpoint pen. Please press firmly and print clearly. Please fill in blanks, underline or circle the correct answers. Send top three copies to Kansas Department of Health and Environment, Bureau of Water, Geology Section, 1000 SW Jackson St., Ste. 420, Topeka, Kansas 66612-1367. Telephone: 785/296-5522. Send one to Water Well Owner and retain one for your records. Visit us at <http://www.kdheks.gov/geo/waterwells>.