


1 LOCATION OF WATER WELL: County: Franklin Fraction: NE 1/4 NW 1/4 SE 1/4 Section Number: 35 Township Number: T 16 S R 17 Range Number: EW
 Distance and direction from nearest town or city street address of well if located within city?
2.3 West and .4 North from the center of Pomona, KS.

2 WATER WELL OWNER: Judd Ranch
 RR#, St. Address, Box #: 423 Hwy 68 Board of Agriculture, Division of Water Resources
 City, State, ZIP Code: Pomona, KS. 66076 Application Number:

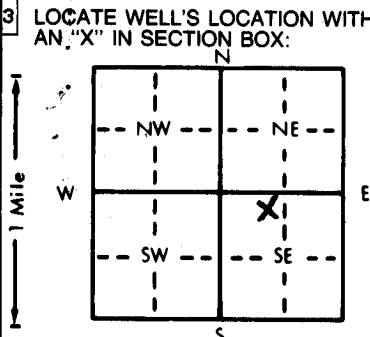

4 DEPTH OF COMPLETED WELL: 260 ft. ELEVATION:
 Depth(s) Groundwater Encountered 1. 181-245 ft. 2. ft. 3. ft.
 WELL'S STATIC WATER LEVEL: 132 ft. below land surface measured on mo/day/yr 8-13-97
 Pump test data: Well water was ft. after hours pumping gpm
 Est. Yield 7 gpm; Well water was ft. after hours pumping gpm
 Bore Hole Diameter: 8 3/4 in. to 260 in. to in. to ft.
 WELL WATER TO BE USED AS: 5 Public water supply 8 Air conditioning 11 Injection well
 ① Domestic 3 Feedlot 6 Oil field water supply 9 Dewatering 12 Other (Specify below)
 2 Irrigation 4 Industrial 7 Lawn and garden only 10 Monitoring well
 Was a chemical/bacteriological sample submitted to Department? Yes.....No X.....; If yes, mo/day/yr sample was submitted Water Well Disinfected? Yes X No

5 TYPE OF BLANK CASING USED:
 1 Steel 3 RMP (SR) 5 Wrought iron 8 Concrete tile CASING JOINTS: Glued X Clamped
 ② PVC 4 ABS 6 Asbestos-Cement 9 Other (specify below) Welded
 7 Fiberglass Threaded
 Blank casing diameter 5 in. to 250 ft., Dia. in. to in. to ft., Dia. in. to in. to ft.
 Casing height above land surface: 30 in., weight 200PSI lbs./ft. Wall thickness or gauge No.
 TYPE OF SCREEN OR PERFORATION MATERIAL:
 1 Steel 3 Stainless steel 5 Fiberglass ⑦ PVC 10 Asbestos-cement
 2 Brass 4 Galvanized steel 6 Concrete tile 9 ABS 11 Other (specify)
 12 None used (open hole)
 SCREEN OR PERFORATION OPENINGS ARE:
 1 Continuous slot ③ Mill slot 5 Gauzed wrapped 8 Saw cut 11 None (open hole)
 2 Louvered shutter 4 Key punched 6 Wire wrapped 9 Drilled holes
 7 Torch cut 10 Other (specify)
 SCREEN-PERFORATED INTERVALS: From 250 ft. to 260 ft., From ft. to ft.
 From ft. to ft., From ft. to ft.
 GRAVEL PACK INTERVALS: From 260 ft. to 145 ft., From 138 ft. to 20 ft.
 From ft. to ft., From ft. to ft.

6 GROUT MATERIAL: 1 Neat cement 2 Cement grout ③ Bentonite 4 Other
 Grout Intervals: From 145 ft. to 138 ft., From 20 ft. to 0 ft., From ft. to ft.
 What is the nearest source of possible contamination:
 1 Septic tank 4 Lateral lines 7 Pit privy 10 Livestock pens 14 Abandoned water well
 2 Sewer lines 5 Cess pool 8 Sewage lagoon 11 Fuel storage 15 Oil well/Gas well
 3 Watertight sewer lines 6 Seepage pit 9 Feedyard 12 Fertilizer storage ⑬ Other (specify below)
Pasture & Cattle
 Direction from well? Every Direction How many feet?

FROM	TO	LITHOLOGIC LOG	FROM	TO	PLUGGING INTERVALS Log Cont.
0	1	Soil	100	105	Shale
1	3	Limestone	105	135	Fine grey sand
3	10	Clay	135	160	Shale
10	15	black shale	160	165	medium grained sand
15	18	Limestone	165	168	Shale
18	19	shale	168	180	Fine grained sand
19	38	Limestone	180	181	Limestone
38	45	Shale	181	245	coarse grained sand
45	50	Limestone	245	260	Shale
50	55	Shale			
55	60	Limestone			
60	68	Fine grey sand			
68	70	Limestone			
70	98	Fine grey sand			
98	100	coal			

7 CONTRACTOR'S OR LANDOWNER'S CERTIFICATION: This water well was ① constructed, (2) reconstructed, or (3) plugged under my jurisdiction and was completed on (mo/day/year) 8-13-97 and this record is true to the best of my knowledge and belief. Kansas Water Well Contractor's License No. 561 This Water Well Record was completed on (mo/day/yr) 8-14-97 under the business name of EVANS Energy Development, Inc. by (signature) S. P. E.

INSTRUCTIONS: Use typewriter or ball point pen. PLEASE PRESS FIRMLY and PRINT clearly. Please fill in blanks, underline or circle the correct answers. Send top three copies to Kansas Department of Health and Environment, Bureau of Water, Topeka, Kansas 66620-0001. Telephone: 913-296-5545. Send one to WATER WELL OWNER and retain one for your records.

OFFICE USE ONLY T R EW SEC.