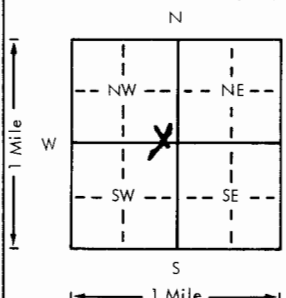
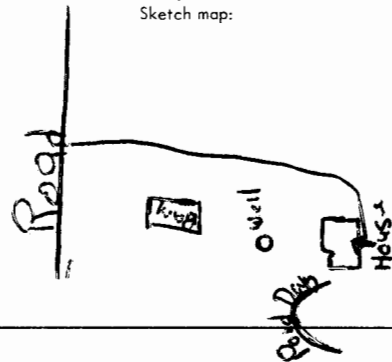


USE TYPEWRITER OR BALL
POINT PEN-PRESS FIRMLY,
PRINT CLEARLY.

WATER WELL RECORD
KSA 82a-1201-1215

Kansas Department of Health and
Environment-Division of Environment
(Water well Contractors)
Topeka, Kansas 66620

1. Location of well:		County Franklin	Frontage SE 1/4 NE 1/4 NW 1/4	Section number 11	Township number T 16 S	Range number R 17 E
2. Distance and direction from nearest town or city:		Michigan Valley		3. Owner of well: Gray Rodgers		
Street address of well location if in city:		1 East 1/4 South		R.R. or street: City, state, zip code: Queaena, Kan. 66067		
4. Locate with "X" in section below:		Sketch map:		6. Bore hole dia. 6 1/2 in. Completion date 7-20-79 Well depth 265 ft. 714029		
				7. <input checked="" type="checkbox"/> Cable tool <input type="checkbox"/> Rotary <input type="checkbox"/> Driven <input type="checkbox"/> Dug <input type="checkbox"/> Hollow rod <input type="checkbox"/> Jetted <input type="checkbox"/> Bored <input type="checkbox"/> Reverse rotary		
5. Type and color of material		From		To		8. Use: <input checked="" type="checkbox"/> Domestic <input type="checkbox"/> Public supply <input type="checkbox"/> Industry <input type="checkbox"/> Irrigation <input type="checkbox"/> Air conditioning <input type="checkbox"/> Stock <input type="checkbox"/> Lawn <input type="checkbox"/> Oil field water <input type="checkbox"/> Other
soil		0		5		9. Casing: Material <input type="checkbox"/> Height: Above or below Threaded <input type="checkbox"/> Welded <input type="checkbox"/> Surface 18 in. RMP <input type="checkbox"/> PVC <input checked="" type="checkbox"/> Weight sch 40 lbs./ft. Dia. 5 in. to 265 ft. depth Wall thickness: inches or Dia. 4 1/2 in. to 29 ft. depth gage No. sch 40
yellow sand		5		29		10. Screen: Manufacturer's name crown line Type pvc Dia. 5 Slot/gauze 3/8 Length 30 Set between 235 ft. and 265 ft. _____ ft. and _____ ft. Gravel pack? no Size range of material _____
lime		29		32		11. Static water level: _____ mo./day/yr. 170 ft. below land surface Date 7-20-79
shald		32		46		12. Pumping level below land surfaces: _____ ft. after _____ hrs. pumping _____ g.p.m. _____ ft. after _____ hrs. pumping _____ g.p.m. Estimated maximum yield _____ g.p.m.
lime		46		61		13. Water sample submitted: _____ mo./day/yr. Yes <input checked="" type="checkbox"/> No <input type="checkbox"/> Date _____
shald		61		85		14. Well head completion: pump House <input type="checkbox"/> Pitless adapter _____ inches above grade
lime		85		105		15. Well grouted? _____ With: <input checked="" type="checkbox"/> Neat cement <input type="checkbox"/> Bentonite <input type="checkbox"/> Concrete Depth: From _____ ft. to _____ ft.
Black shald		105		110		16. Nearest source of possible contamination: ft. _____ Direction _____ Type _____ Well disinfected upon completion? <input checked="" type="checkbox"/> Yes <input type="checkbox"/> No
lime		110		113		17. Pump: _____ Not installed Manufacturer's name Red Jacket Model number 50MBC HP 3 Volts 220 Length of drop pipe _____ ft. capacity _____ g.p.m. Type: <input checked="" type="checkbox"/> Submersible <input type="checkbox"/> Turbine <input type="checkbox"/> Jet <input type="checkbox"/> Reciprocating <input type="checkbox"/> Centrifugal <input type="checkbox"/> Other
grey sand		113		170		
shald		170		235		
white sand		235		265		
(Use a second sheet if needed)						
18. Elevation:	19. Remarks:		20. Water well contractor's certification:			
Topography: <input checked="" type="checkbox"/> Hill <input type="checkbox"/> Slope <input type="checkbox"/> Upland <input type="checkbox"/> Valley	Just started building a House and barn. No contamination as of yet.		This well was drilled under my jurisdiction and this report is true to the best of my knowledge and belief. Royce Swank Drilling 371 Business name Address 234 Ottawa, Kan. 66067 License No. _____ Signed Royce Swank Date 7-20-79 Authorized representative			

Forward the white, blue and pink copies to the Department of Health and Environment

Form WWC-5