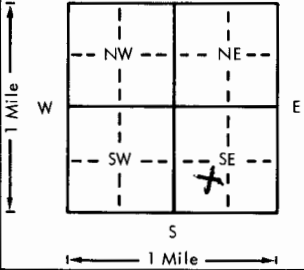
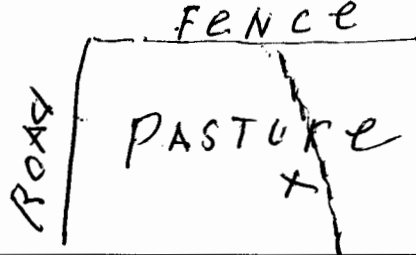


USE TYPEWRITER OR BALL
POINT PEN-PRESS FIRMLY,
PRINT CLEARLY.

WATER WELL RECORD
KSA 82a-1201-1215

Kansas Department of Health and
Environment-Division of Environment
(Water well Contractors)
Topeka, Kansas 66620

1. Location of well:		County Franklin	Fraction NE 1/4 SW 1/4 NE 1/4	Section number 14	Township number T 16	Range number S R 17 E/W
2. Distance and direction from nearest town or city: 1 MI W 3 MIN Street address of well location if in city: 1/2 N W Pomona		3. Owner of well: Gene Miller R.R. or street: City, state, zip code: Pomona, Kansas, 66076				
4. Locate with "X" in section below: 		Sketch map: 		6. Bore hole dia. 6 in. Completion date 5-30-77 Well depth 320 ft. 8" TO 15"		
5. Type and color of material		From	To	7. <input checked="" type="checkbox"/> Cable tool <input type="checkbox"/> Rotary <input type="checkbox"/> Driven <input type="checkbox"/> Dug <input type="checkbox"/> Hollow rod <input type="checkbox"/> Jetted <input type="checkbox"/> Bored <input type="checkbox"/> Reverse rotary		
soil		0	1	8. Use: <input type="checkbox"/> Domestic <input type="checkbox"/> Public supply <input type="checkbox"/> Industry <input type="checkbox"/> Irrigation <input type="checkbox"/> Air conditioning <input checked="" type="checkbox"/> Stock <input type="checkbox"/> Lawn <input type="checkbox"/> Oil field water <input type="checkbox"/> Other		
shelly rock		1	6	9. Casing: Material PVC Height: Above 12 in. Threaded <input type="checkbox"/> Welded <input type="checkbox"/> Surface <input type="checkbox"/> Dia. 5 in. RMP <input type="checkbox"/> PVC <input checked="" type="checkbox"/> Weight 350 lbs./ft. Dia. 5 in. to 320 ft. depth Wall Thickness: inches or Dia. 5 in. to 320 ft. depth gage No. 365 Sch 40		
gray shald		6	24	10. Screen: Manufacturer's name CHOWN LINE Type PVC Dia. 5 in. Slot/gauze 28 Length 20 Set between 300 ft. and 320 ft. ft. and ft. Gravel pack? NO Size range of material		
lime shald		24	29	11. Static water level: 200 ft. below land surface Date 5-30-77		
shald		29	60	12. Pumping level below land surfaces: ft. after hrs. pumping g.p.m. ft. after hrs. pumping g.p.m. Estimated maximum yield 3 g.p.m.		
lime		60	65	13. Water sample submitted: NO mo./day/yr. Yes <input checked="" type="checkbox"/> No <input type="checkbox"/> Date		
shald		65	116	14. Well head completion pump house Pitless adapter <input type="checkbox"/> Inches above grade		
lime		116	135	15. Well grouted? <input checked="" type="checkbox"/> With: <input checked="" type="checkbox"/> Neat cement <input type="checkbox"/> Bentonite <input type="checkbox"/> Concrete Depth: From 0 ft. to 15 ft.		
shald		135	140	16. Nearest source of possible contamination: ft. NONE Direction Type Well disinfected upon completion? <input type="checkbox"/> Yes <input checked="" type="checkbox"/> No		
coal		140	146	17. Pump: <input type="checkbox"/> Not installed Manufacturer's name Model number HP Volts Length of drop pipe ft. capacity g.p.m. Type: <input type="checkbox"/> Submersible <input type="checkbox"/> Turbine <input type="checkbox"/> Jet <input type="checkbox"/> Reciprocating <input type="checkbox"/> Centrifugal <input checked="" type="checkbox"/> Other		
black shald		146	148	20. Water well contractor's certification: This well was drilled under my jurisdiction and this report is true to the best of my knowledge and belief. Edgar Swank Drilling 124A Business name License No. Address R. 4 Ottawa, Kansas Signed Edgar Swank Date 6-11-77 Authorized representative		
lime		148	150			
sand shald		150	268			
white lime		268	279			
sand shald		279	300			
gray sand (Use a second sheet if needed)		300	320			
18. Elevation:		19. Remarks: This well was drilled in the pasture for stock water.				
Topography: <input type="checkbox"/> Hill <input type="checkbox"/> Slope <input checked="" type="checkbox"/> Upland <input type="checkbox"/> Valley						

Forward the white, blue and pink copies to the Department of Health and Environment

Form WWC-5