


1 LOCATION OF WATER WELL: Fraction SW 1/4 SE 1/4 SE 1/4 Section Number 26 Township Number T 16 S Range Number R 17 EW  
 County: FRANKLIN

Distance and direction from nearest town or city street address of well if located within city?  
 1 3/4 west, 1 1/2 north of Pomona

2 WATER WELL OWNER: Gene Miller  
 RR#, St. Address, Box # : 248 Pawnee Rd. Board of Agriculture, Division of Water Resources  
 City, State, ZIP Code : Pomona, KS 66076 Application Number:

3 LOCATE WELL'S LOCATION WITH AN "X" IN SECTION BOX:

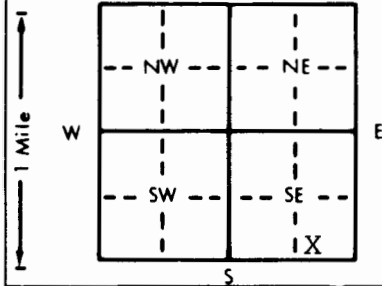

4 DEPTH OF COMPLETED WELL 220' ft. ELEVATION:  
 Depth(s) Groundwater Encountered 1. 180-200' ft. 2. ft. 3. ft.  
 WELL'S STATIC WATER LEVEL 114' ft. below land surface measured on mo/day/yr 3-04-92.  
 Pump test data: Well water was ft. after hours pumping gpm  
 Est. Yield 12 gpm: Well water was ft. after hours pumping gpm  
 Bore Hole Diameter 8 3/4 in. to ft. and in. to ft.  
 WELL WATER TO BE USED AS: 5 Public water supply 8 Air conditioning 11 Injection well  
 1 Domestic 3 Feedlot 6 Oil field water supply 9 Dewatering 12 Other (Specify below)  
 2 Irrigation 4 Industrial 7 Lawn and garden only 10 Monitoring well  
 Was a chemical/bacteriological sample submitted to Department? Yes No X; If yes, mo/day/yr sample was submitted  
 Water Well Disinfected? Yes X No

5 TYPE OF BLANK CASING USED: 5 Wrought iron 8 Concrete tile CASING JOINTS: Glued X Clamped  
 1 Steel 3 RMP (SR) 6 Asbestos-Cement 9 Other (specify below) Welded  
 2 PVC 4 ABS 7 Fiberglass Threaded

Blank casing diameter 5" in. to 0-180 ft. Dia in. to ft. Dia in. to ft.  
 Casing height above land surface 24" in. weight 2.82 lbs./ft. Wall thickness or gauge No. 258

TYPE OF SCREEN OR PERFORATION MATERIAL: 7 PVC 10 Asbestos-cement  
 1 Steel 3 Stainless steel 5 Fiberglass 8 RMP (SR) 11 Other (specify)  
 2 Brass 4 Galvanized steel 6 Concrete tile 9 ABS 12 None used (open hole)

SCREEN OR PERFORATION OPENINGS ARE: 5 Gauzed wrapped 8 Saw cut 11 None (open hole)  
 1 Continuous slot 3 Mill slot 6 Wire wrapped 9 Drilled holes  
 2 Louvered shutter 4 Key punched 7 Torch cut 10 Other (specify)

SCREEN-PERFORATED INTERVALS: From 180 ft. to 220 ft. From ft. to ft.  
 From ft. to ft. From ft. to ft.  
 GRAVEL PACK INTERVALS: From 24 ft. to 220 ft. From ft. to ft.  
 From ft. to ft. From ft. to ft.

6 GROUT MATERIAL: 1 Neat cement 2 Cement grout 3 Bentonite 4 Other  
 Grout Intervals: From 0 ft. to 24 ft. From ft. to ft. From ft. to ft.

What is the nearest source of possible contamination:  
 1 Septic tank 4 Lateral lines 7 Pit privy 10 Livestock pens 14 Abandoned water well  
 2 Sewer lines 5 Cess pool 8 Sewage lagoon 11 Fuel storage 15 Oil well/Gas well  
 3 Watertight sewer lines 6 Seepage pit 9 Feedyard 12 Fertilizer storage 16 Other (specify below)  
 13 Insecticide storage

Direction from well? north How many feet? 110'

FROM	TO	LITHOLOGIC LOG	FROM	TO	PLUGGING INTERVALS
0	7	Clay-Brown	101	110	Sandstone-Grey
7	17	Limestone-Yellow	110	115	Limestone-Grey
17	25	Shale-Grey	115	119	Sandstone-Grey
25	27	Limestone-Grey	119	120	Limestone-Grey
27	28	Shale-Grey	120	125	Sandstone-Grey
28	32	Limestone-Grey	125	150	Shale-Grey
32	35	Shale-Grey	150	155	Sandstone-Grey
35	42	Limestone-Grey	155	181	Shale-Grey
42	64	Shale-Grey	181	220	Sandstone-Grey
64	69	Limestone-Grey			
69	78	Shale-Grey			
78	79	Limestone-Grey			
79	85	Shale-Grey			
85	97	Sandstone-Grey			
97	101	Limestone-Grey			

7 CONTRACTOR'S OR LANDOWNER'S CERTIFICATION: This water well was (1) constructed, (2) reconstructed, or (3) plugged under my jurisdiction and was completed on (mo/day/year) 3-04-92 and this record is true to the best of my knowledge and belief. Kansas Water Well Contractor's License No. 182 This Water Well Record was completed on (mo/day/yr) 4-7-92 under the business name of STRADER DRILLING CO., INC. by (signature) Dale Strader