


1 LOCATION OF WATER WELL: County: **Franklin** Fraction: **SW 1/4 SW 1/4 NE 1/4** Section Number: **1** Township Number: **T 16 S** Range Number: **R 18 EW**

Distance and direction from nearest town or city street address of well if located within city? **2 miles South and 1 West of Centropolis KS.**

2 WATER WELL OWNER: **Larry Anderson**
 RR#, St. Address, Box #: **1570 Riley Road**
 City, State, ZIP Code: **Pomona KS 66076**
 Board of Agriculture, Division of Water Resources
 Application Number:

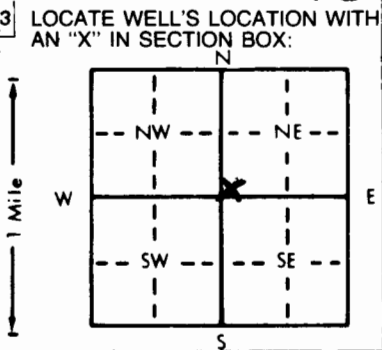

4 DEPTH OF COMPLETED WELL: **90** ft. ELEVATION:
 Depth(s) Groundwater Encountered: 1. **70-89** ft. 2. ft. 3. ft.
 WELL'S STATIC WATER LEVEL: **36** ft. below land surface measured on mo/day/yr **6-29-95**
 Pump test data: Well water was ft. after hours pumping gpm
 Est. Yield: **10** gpm; Well water was ft. after hours pumping gpm
 Bore Hole Diameter: **8 3/4** in. to **90** ft., and in. to ft.
 WELL WATER TO BE USED AS:
 1 Domestic 3 Feedlot 6 Oil field water supply 9 Dewatering 12 Other (Specify below)
 2 Irrigation 4 Industrial 7 Lawn and garden only 10 Monitoring well
 Was a chemical/bacteriological sample submitted to Department? Yes.....No.....; If yes, mo/day/yr sample was submitted
 Water Well Disinfected? Yes No

5 TYPE OF BLANK CASING USED:
 1 Steel 3 RMP (SR) 5 Wrought iron 8 Concrete tile CASING JOINTS: Glued Clamped
 2 PVC 4 ABS 7 Fiberglass 9 Other (specify below) Welded
 Blank casing diameter: **5** in. to ft., Dia. in. to ft., Dia. in. to ft.
 Casing height above land surface: **30** in., weight: **200#** lbs./ft. Wall thickness or gauge No.
 TYPE OF SCREEN OR PERFORATION MATERIAL:
 1 Steel 3 Stainless steel 5 Fiberglass 7 PVC 10 Asbestos-cement
 2 Brass 4 Galvanized steel 6 Concrete tile 8 RMP (SR) 11 Other (specify)
 3 Screen or perforation openings are:
 1 Continuous slot 3 Mill slot 5 Gauzed wrapped 8 Saw cut 11 None (open hole)
 2 Louvered shutter 4 Key punched 6 Wire wrapped 9 Drilled holes
 7 Torch cut 10 Other (specify)
 SCREEN-PERFORATED INTERVALS: From **30** ft. to **90** ft., From ft. to ft.
 GRAVEL PACK INTERVALS: From **90** ft. to **20** ft., From ft. to ft.

6 GROUT MATERIAL: 1 Neat cement 2 Cement grout 3 Bentonite 4 Other
 Grout Intervals: From **20** ft. to ft., From ft. to ft., From ft. to ft.
 What is the nearest source of possible contamination: **NONE At time of Drilling**
 1 Septic tank 4 Lateral lines 7 Pit privy 10 Livestock pens 14 Abandoned water well
 2 Sewer lines 5 Cess pool 8 Sewage lagoon 11 Fuel storage 15 Oil well/Gas well
 3 Watertight sewer lines 6 Seepage pit 9 Feedyard 12 Fertilizer storage 16 Other (specify below)
 13 Insecticide storage
 Direction from well? How many feet?

FROM	TO	LITHOLOGIC LOG	FROM	TO	PLUGGING INTERVALS
0	10	Brown Sandstone			
10	70	Yellow Sandstone			
70	89	Large grained Sandstone			
89	90	Shale			

7 CONTRACTOR'S OR LANDOWNER'S CERTIFICATION: This water well was (1) constructed, (2) reconstructed, or (3) plugged under my jurisdiction and was completed on (mo/day/year) **6-29-95** and this record is true to the best of my knowledge and belief. Kansas Water Well Contractor's License No. **561** This Water Well Record was completed on (mo/day/yr) **6-30-95** under the business name of **ERANS ENERGY Dev. Inc.** by (signature) *[Signature]*