


1 LOCATION OF WATER WELL: County: Franklin Fraction: NE 1/4 SE 1/4 SE 1/4 Section Number: 35 Township Number: T 16 S Range Number: R 18 E

Distance and direction from nearest town or city street address of well if located within city?
4 East on 114 miles North of Pomona, Ks.

2 WATER WELL OWNER: Don Meyers
 RR#, St. Address, Box #: P.O. Box 932
 City, State, ZIP Code: Ottawa, Ks, 66067
 Board of Agriculture, Division of Water Resources
 Application Number:

3 LOCATE WELL'S LOCATION WITH AN "X" IN SECTION BOX:

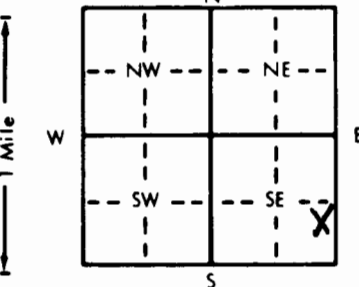

4 DEPTH OF COMPLETED WELL: 120 ft. ELEVATION:
 Depth(s) Groundwater Encountered 1. 45-120 ft. 2. ft. 3. ft.
 WELL'S STATIC WATER LEVEL 28 ft. below land surface measured on mo/day/yr 9-14-95
 Pump test data: Well water was ft. after hours pumping gpm
 Est. Yield 20 gpm; Well water was ft. after hours pumping gpm
 Bore Hole Diameter: 8 1/4 in. to 20 ft., and 7 7/8 in. to 120 ft.
 WELL WATER TO BE USED AS:
 1 Domestic 3 Feedlot 6 Oil field water supply 9 Dewatering 12 Other (Specify below)
 2 Irrigation 4 Industrial 7 Lawn and garden only 10 Monitoring well
 Was a chemical/bacteriological sample submitted to Department? Yes..... No If yes, mo/day/yr sample was sub-
 mitted Water Well Disinfected? Yes No

5 TYPE OF BLANK CASING USED:
 1 Steel 3 RMP (SR) 5 Wrought iron 8 Concrete tile CASING JOINTS: Glued Clamped
 2 PVC 4 ABS 6 Asbestos-Cement 9 Other (specify below) Welded
 7 Fiberglass Threaded

Blank casing diameter 5 in. to 110 ft., Dia. in. to ft., Dia. in. to ft.
 Casing height above land surface 30 in., weight 200# lbs./ft. Wall thickness or gauge No.

TYPE OF SCREEN OR PERFORATION MATERIAL:
 1 Steel 3 Stainless steel 5 Fiberglass 7 PVC 10 Asbestos-cement
 2 Brass 4 Galvanized steel 6 Concrete tile 9 ABS 11 Other (specify)

SCREEN OR PERFORATION OPENINGS ARE:
 1 Continuous slot 3 Mill slot 5 Gauzed wrapped 8 Saw cut 11 None (open hole)
 2 Louvered shutter 4 Key punched 6 Wire wrapped 9 Drilled holes
 7 Torch cut 10 Other (specify)

SCREEN-PERFORATED INTERVALS: From 110 ft. to 120 ft., From ft. to ft.
 GRAVEL PACK INTERVALS: From 120 ft. to 20 ft., From ft. to ft.

6 GROUT MATERIAL: 1 Neat cement 2 Cement grout 3 Bentonite 4 Other
 Grout Intervals: From 20 ft. to 0 ft., From ft. to ft.

What is the nearest source of possible contamination:
 1 Septic tank 4 Lateral lines 7 Pit privy 10 Livestock pens 14 Abandoned water well
 2 Sewer lines 5 Cess pool 8 Sewage lagoon 11 Fuel storage 15 Oil well/Gas well
 3 Watertight sewer lines 6 Seepage pit 9 Feedyard 12 Fertilizer storage 16 Other (specify below)
 13 Insecticide storage

Direction from well? West How many feet? 150

FROM	TO	LITHOLOGIC LOG	FROM	TO	PLUGGING INTERVALS
0	17	Soil & clay			
17	21	Brown sand			
21	30	Sand & gravel			
30	45	Brown sand			
45	120	White Sand - Water			

7 CONTRACTOR'S OR LANDOWNER'S CERTIFICATION: This water well was (1) constructed, (2) reconstructed, or (3) plugged under my jurisdiction and was completed on (mo/day/year) Sept 14, 95 and this record is true to the best of my knowledge and belief, Kansas Water Well Contractor's License No. 561 This Water Well Record was completed on (mo/day/year) Sept 19, 95 under the business name of EVANS Energy Dev Inc. by (signature) [Signature]