


1 LOCATION OF WATER WELL: County: Franklin Fraction: NE 1/4 NE 1/4 NW 1/4 Section Number: 19 Township Number: T 16 S Range Number: R 18 E
 Distance and direction from nearest town or city street address of well if located within city?
3 North and 1/2 West of K-68 in Pomona

2 WATER WELL OWNER: Rick Griffen
 RR#, St. Address, Box #: Rt. 1 Box 491A Board of Agriculture, Division of Water Resources
 City, State, ZIP Code: Pomona, KS. 66076 Application Number:

3 LOCATE WELL'S LOCATION WITH AN "X" IN SECTION BOX:

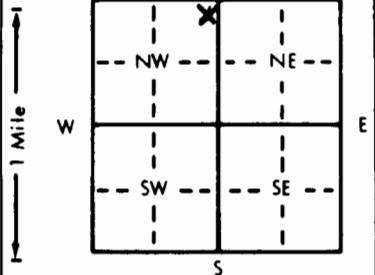

4 DEPTH OF COMPLETED WELL: 325 ft. ELEVATION:
 Depth(s) Groundwater Encountered 1. 300-325 ft. 2. ft. 3. ft.
 WELL'S STATIC WATER LEVEL 111 ft. below land surface measured on mo/day/yr 4-2-97
 Pump test data: Well water was ft. after hours pumping gpm
 Est. Yield 30 gpm. Well water was ft. after hours pumping gpm
 Bore Hole Diameter 8 3/4 in. to 20 ft. and 7 7/8 in. to 325 ft.
 WELL WATER TO BE USED AS:
 Domestic 3 Feedlot 6 Oil field water supply 9 Dewatering 11 Injection well
 Irrigation 4 Industrial 7 Lawn and garden only 10 Monitoring well
 Was a chemical/bacteriological sample submitted to Department? Yes. No. If yes, mo/day/yr sample was submitted
 Water Well Disinfected? Yes No

5 TYPE OF BLANK CASING USED:
 1 Steel 3 RMP (SR) 5 Wrought iron 8 Concrete tile CASING JOINTS: Glued Clamped
 PVC 4 ABS 6 Asbestos-Cement 9 Other (specify below) Welded
 7 Fiberglass Threaded
 Blank casing diameter: 5 in. to 3.15 ft., Dia. in. to ft., Dia. in. to ft.
 Casing height above land surface: 24" in., weight 200 PSI lbs./ft. Wall thickness or gauge No.

TYPE OF SCREEN OR PERFORATION MATERIAL:
 1 Steel 3 Stainless steel 5 Fiberglass 8 RMP (SR) 10 Asbestos-cement
 2 Brass 4 Galvanized steel 6 Concrete tile 9 ABS 11 Other (specify)
 12 None used (open hole)

SCREEN OR PERFORATION OPENINGS ARE:
 1 Continuous slot 3 Mill slot 5 Gauzed wrapped 8 Saw cut 11 None (open hole)
 2 Louvered shutter 4 Key punched 6 Wire wrapped 9 Drilled holes
 7 Torch cut 10 Other (specify)

SCREEN-PERFORATED INTERVALS: From 315 ft. to 325 ft., From ft. to ft.
 From ft. to ft., From ft. to ft.
 GRAVEL PACK INTERVALS: From 325 ft. to 20 ft., From ft. to ft.
 From ft. to ft., From ft. to ft.

6 GROUT MATERIAL: 1 Neat cement 2 Cement grout 3 Bentonite 4 Other
 Grout Intervals: From 20 ft. to 0 ft., From ft. to ft., From ft. to ft.
 What is the nearest source of possible contamination: none at time of Drilling
 1 Septic tank 4 Lateral lines 7 Pit privy 11 Fuel storage 14 Abandoned water well
 2 Sewer lines 5 Cess pool 8 Sewage lagoon 12 Fertilizer storage 15 Oil well/Gas well
 3 Watertight sewer lines 6 Seepage pit 9 Feedyard 13 Insecticide storage 16 Other (specify below)

Direction from well? How many feet?

FROM	TO	LITHOLOGIC LOG	FROM	TO	PLUGGING INTERVALS
0	18	Soil + Clay	25	285	shale
18	35	Limestone	285	290	limestone
35	45	Black Shale	290	300	shale
45	50	limestone	300	325	sandstone
50	60	shale			
60	80	limestone			
80	85	shale			
85	88	limestone			
88	100	shale			
100	160	Silty shale - grey			
160	165	limestone			
165	175	shale			
175	185	limestone			
185	205	shale			
205	275	sandstone - grey, fine gravel			

7 CONTRACTOR'S OR LANDOWNER'S CERTIFICATION: This water well was constructed, reconstructed, or plugged under my jurisdiction and was completed on (mo/day/year) 4-2-97 and this record is true to the best of my knowledge and belief. Kansas Water Well Contractor's License No. 561 This Water Well Record was completed on (mo/day/yr) 4-3-97 under the business name of EVANS Energy Development, Inc. by (signature) [Signature]

OFFICE USE ONLY
T
R
EW
SEC.
1/4
1/4
1/4