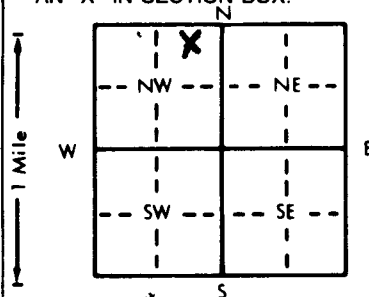


1 LOCATION OF WATER WELL: County: **FRANKLIN** Fraction: **NE 1/4 NE 1/4 NW 1/4** Section Number: **6** Township Number: **T 16 S** Range Number: **R 18 W**

Distance and direction from nearest town or city street address of well if located within city?
1/2 mile East of Pomona, KS

2 WATER WELL OWNER: **Kenneth Fielden**
 RR#, St. Address, Box #: **8576 Georgia**
 City, State; ZIP Code: **(Kansas City), KS 66109**
 Board of Agriculture, Division of Water Resources
 Application Number:

3 LOCATE WELL'S LOCATION WITH AN "X" IN SECTION BOX:


4 DEPTH OF COMPLETED WELL: **28** ft. ELEVATION:
 Depth(s) Groundwater Encountered 1. ft. 2. ft. 3. ft.
 WELL'S STATIC WATER LEVEL: **20** ft. below land surface measured on mo/day/yr **12-22-97**
 Pump test data: Well water was ft. after hours pumping gpm
 Est. Yield gpm: Well water was ft. after hours pumping gpm
 Bore Hole Diameter: **5'** in. to ft., and in. to ft.
 WELL WATER TO BE USED AS:
 Domestic 3 Feedlot 6 Oil field water supply 9 Dewatering 12 Other (Specify below)
 2 Irrigation 4 Industrial 7 Lawn and garden only 10 Monitoring well
 Was a chemical/bacteriological sample submitted to Department? Yes No ; If yes, mo/day/yr sample was submitted
 Water Well Disinfected? Yes No

5 TYPE OF BLANK CASING USED:
 1 Steel 3 RMP (SR) 5 Wrought iron 8 Concrete tile CASING JOINTS: Glued Clamped
 2 PVC 4 ABS 6 Asbestos-Cement Other (specify below) **Dug Well** Welded
 7 Fiberglass Threaded
 Blank casing diameter: **5'** in. to ft., Dia in. to ft., Dia in. to ft.
 Casing height above land surface: **4'** in., weight lbs./ft. Wall thickness or gauge No.
 TYPE OF SCREEN OR PERFORATION MATERIAL:
 1 Steel 3 Stainless steel 5 Fiberglass 8 RMP (SR) 11 Other (specify) **N/A**
 2 Brass 4 Galvanized steel 6 Concrete tile 9 ABS None used (open hole)
 SCREEN OR PERFORATION OPENINGS ARE:
 1 Continuous slot 3 Mill slot 5 Gauzed wrapped 8 Saw cut None (open hole)
 2 Louvered shutter 4 Key punched 6 Wire wrapped 9 Drilled holes **N/A**
 7 Torch cut 10 Other (specify)
 SCREEN-PERFORATED INTERVALS: From ft. to ft., From ft. to ft.
 From ft. to ft., From ft. to ft.
 GRAVEL PACK INTERVALS: From ft. to ft., From ft. to ft.
 From ft. to ft., From ft. to ft.

6 GROUT MATERIAL: 1 Neat cement 2 Cement grout Bentonite 4 Other
 Grout Intervals: From ft. to ft., From ft. to ft.
 What is the nearest source of possible contamination:
 1 Septic tank Lateral lines 7 Pit privy 10 Livestock pens 14 Abandoned water well
 2 Sewer lines 5 Cess pool 8 Sewage lagoon 11 Fuel storage 15 Oil well/Gas well
 3 Watertight sewer lines 6 Seepage pit 9 Feedyard 12 Fertilizer storage 16 Other (specify below)
 13 Insecticide storage
 Direction from well? **EAST** How many feet? **50'**

| FROM | TO | LITHOLOGIC LOG | FROM | TO | PLUGGING INTERVALS |
|------|----|----------------|------|----|--------------------|
| | | | | | Ground Level |
| | | | | | SOIL 4' |
| | | | | | BENTONITE 20' |
| | | | | | GRAVEL 4' |

7 CONTRACTOR'S OR LANDOWNER'S CERTIFICATION: This water well was (1) constructed, (2) reconstructed, or plugged under my jurisdiction and was completed on (mo/day/year) **12-22-97** and this record is true to the best of my knowledge and belief. Kansas Water Well Contractor's License No. **536** This Water Well Record was completed on (mo/day/yr) **12-23-97** under the business name of **Parker Pump & Well Drilling Inc** by (signature) **Jim Eltchen**