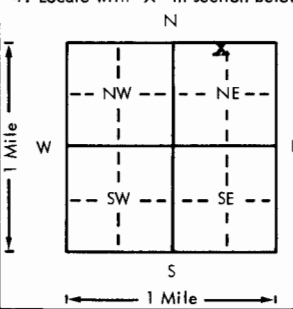
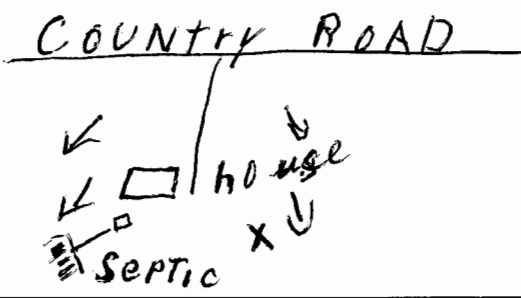


USE TYPEWRITER OR BALL POINT PEN-PRESS FIRMLY, PRINT CLEARLY.

WATER WELL RECORD
KSA 82a-1201-1215

Kansas Department of Health and Environment-Division of Environment
(Water well Contractors)
Topeka, Kansas 66620

1. Location of well:	County Franklin	Fraction N.E. 1/4 N.W. 1/4 N.E. 1/4	Section number 1	Township number T 16	Range number S R 18	E/W	
2. Distance and direction from nearest town or city Street address of well location if in city: 2 South 1 1/4 West Centropolis, Kansas			3. Owner of well: John Bowman R.R. or street: R.R. 4 City, state, zip code: Ottawa, Kansas				
4. Locate with "X" in section below: 			Sketch map: COUNTRY ROAD 			6. Bore hole dia. 6 1/2 in. Completion date 2-7-77 Well depth 87 ft. 9" to 18"	
5. Type and color of material			From	To		7. <input checked="" type="checkbox"/> Cable tool <input type="checkbox"/> Rotary <input type="checkbox"/> Driven <input type="checkbox"/> Dug <input type="checkbox"/> Hollow rod <input type="checkbox"/> Jetted <input type="checkbox"/> Bored <input type="checkbox"/> Reverse rotary	
			Soil	0	5		8. Use: <input checked="" type="checkbox"/> Domestic <input type="checkbox"/> Public supply <input type="checkbox"/> Industry <input type="checkbox"/> Irrigation <input type="checkbox"/> Air conditioning <input type="checkbox"/> Stock <input type="checkbox"/> Lawn <input type="checkbox"/> Oil field water <input type="checkbox"/> Other
			Yellow Sand	5	45		9. Casing: Material _____ Height: Above ground Threaded _____ Welded _____ Surface 18 in. RMP _____ PVC 3000 Weight _____ lbs./ft. Dia. 6 1/2 in. to 20 ft. depth Wall Thickness: inches or Dia. _____ in. to _____ ft. depth Gage No. sch. 40
			Grey Sank Rock	45	82		10. Screen: Manufacturer's name _____ NONE Type _____ Dia. _____ Slot/gauze _____ Length _____ Set between _____ ft. and _____ ft. _____ ft. and _____ ft. Gravel pack? _____ Size range of material _____
			Lime	82	84		11. Static water level: 40 ft. below land surface Date 2-7-77 mo./day/yr.
Shale	84	87		12. Pumping level below land surfaces: _____ ft. after _____ hrs. pumping _____ g.p.m. _____ ft. after _____ hrs. pumping _____ g.p.m. Estimated maximum yield 10 g.p.m.			
(Use a second sheet if needed)					13. Water sample submitted: _____ mo./day/yr. <input type="checkbox"/> Yes <input checked="" type="checkbox"/> No Date _____		
					14. Well head completion: <input checked="" type="checkbox"/> Pitless adapter 18 Inches above grade		
					15. Well grouted? <input checked="" type="checkbox"/> With: <input checked="" type="checkbox"/> Neat cement _____ Bentonite _____ Concrete _____ Depth: From 3 ft. to 20 ft.		
					16. Nearest source of possible contamination: ft. 100 Direction N.W. Type Septic Well disinfected upon completion? _____ Yes _____ No		
					17. Pump: _____ Not installed Manufacturer's name Red Jacket Model number 50N1-9BC IP 1/2 Volts 230 Length of drop pipe 77 ft. capacity 10 g.p.m. Type: <input checked="" type="checkbox"/> Submersible _____ Turbine <input type="checkbox"/> Jet _____ Reciprocating <input type="checkbox"/> Centrifugal _____ Other _____		
18. Elevation: Topography: <input type="checkbox"/> Hill <input checked="" type="checkbox"/> Slope <input type="checkbox"/> Upland <input type="checkbox"/> Valley	19. Remarks: This well is for a new house. The well & pump is complete. Cement blocks will be poured as soon as. Side work are finish		20. Water well contractor's certification: This well was drilled under my jurisdiction and this report is true to the best of my knowledge and belief. Edgar Swank Drilling 124A Business name _____ License No. _____ Address R.R. 4 Ottawa, Kans. Signed Edgar Swank Date 2-10-77 Authorized representative				

Forward the white, blue and pink copies to the Department of Health and Environment

Form WWC-5