


1 LOCATION OF WATER WELL: Fraction NW 1/4 NW 1/4 NW 1/4 Section Number 3 Township Number T 16 S Range Number R 18 EW
 County: FRANKLIN

Distance and direction from nearest town or city street address of well if located within city?
 3 WEST 1 1/2 SOUTH CENTROPOLIS KANS.

2 WATER WELL OWNER: CRAIG PUFFELL
 RR#, St. Address, Box #: POMOONA KANS.
 City, State, ZIP Code: RR 16617
 Board of Agriculture, Division of Water Resources
 Application Number:

3 LOCATE WELL'S LOCATION WITH AN "X" IN SECTION BOX:

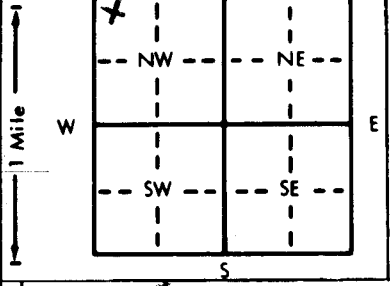

4 DEPTH OF COMPLETED WELL: 261 ft. ELEVATION:
 Depth(s) Groundwater Encountered 1. 150 ft. 2. ft. 3. ft.
 WELL'S STATIC WATER LEVEL: 100 ft. below land surface measured on mo/day/yr 6-3-89
 Pump test data: Well water was ft. after hours pumping gpm
 Est. Yield 7 gpm: Well water was ft. after hours pumping gpm
 Bore Hole Diameter: 9 in. to 20 ft., and in. to ft.
 WELL WATER TO BE USED AS:
 1 Domestic 3 Feedlot 6 Oil field water supply 9 Dewatering 12 Other (Specify below)
 2 Irrigation 4 Industrial 7 Lawn and garden only 10 Monitoring well
 Was a chemical/bacteriological sample submitted to Department? Yes No; If yes, mo/day/yr sample was submitted
 Water Well Disinfected? Yes No

5 TYPE OF BLANK CASING USED:
 1 Steel 3 RMP (SR) 5 Wrought iron 8 Concrete tile CASING JOINTS: Glued Clamped
 2 PVC 4 ABS 6 Asbestos-Cement 9 Other (specify below) Welded
 7 Fiberglass Threaded

Blank casing diameter 5 in. to 150 ft., Dia 5 in. to 240 ft., Dia in. to ft.
 Casing height above land surface: WELL HOUSE in., weight 40 lbs./ft. Wall thickness or gauge No. 40

TYPE OF SCREEN OR PERFORATION MATERIAL:
 1 Steel 3 Stainless steel 5 Fiberglass 8 RMP (SR) 10 Asbestos-cement
 2 Brass 4 Galvanized steel 6 Concrete tile 9 ABS 11 Other (specify)
 12 None used (open hole)

SCREEN OR PERFORATION OPENINGS ARE:
 1 Continuous slot 3 Mill slot 5 Gauzed wrapped 8 Saw cut 11 None (open hole)
 2 Louvered shutter 4 Key punched 6 Wire wrapped 9 Drilled holes
 7 Torch cut 10 Other (specify)

SCREEN-PERFORATED INTERVALS: From 150 ft. to 160 ft., From 240 ft. to 261 ft.
 GRAVEL PACK INTERVALS: From NONE ft. to ft., From ft. to ft.

6 GROUT MATERIAL: 1 Neat cement 2 Cement grout 3 Bentonite 4 Other
 Grout intervals: From 0 ft. to 20 ft., From ft. to ft.

What is the nearest source of possible contamination:
 1 Septic tank 4 Lateral lines 7 Pit privy 10 Livestock pens 14 Abandoned water well
 2 Sewer lines 5 Cess pool 8 Sewage lagoon 11 Fuel storage 15 Oil well/Gas well
 3 Watertight sewer lines 6 Seepage pit 9 Feedyard 12 Fertilizer storage 16 Other (specify below)
 13 Insecticide storage

Direction from well? NORTHWEST How many feet? 200

FROM	TO	LITHOLOGIC LOG	FROM	TO	PLUGGING INTERVALS
0	4	Soil			
4	16	Lime			
16	25	Black Shale			
25	32	Lime			
32	150	Gray Sanded Shale			
150	200	Gray Sand - (Water)			
200	261	Sanded gray shale			

7 CONTRACTOR'S OR LANDOWNER'S CERTIFICATION: This water well was (1) constructed, (2) reconstructed, or (3) plugged under my jurisdiction and was completed on (mo/day/year) 6-3-89 and this record is true to the best of my knowledge and belief. Kansas Water Well Contractor's License No. 486 This Water Well Record was completed on (mo/day/yr) 6-31-89 under the business name of Edgar Swank water well Drilling by (signature) Edgar Swank