


1] LOCATION OF WATER WELL: County: Franklin Fraction: SW 1/4 SW 1/4 SE 1/4 Section Number: 4 Township Number: T 16 S Range Number: R 18 EW

Distance and direction from nearest town or city street address of well if located within city? Pomona
3 North 1 East 1 North 1/2 East

2] WATER WELL OWNER: Lawrence Dyer
 RR#, St. Address, Box # :
 City, State, ZIP Code : Pomona, Kan
 Board of Agriculture, Division of Water Resources
 Application Number:

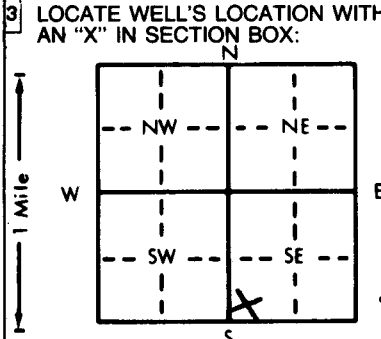

4] DEPTH OF COMPLETED WELL: 124 ft. ELEVATION:
 Depth(s) Groundwater Encountered 1. 45 ft. 2. 30 ft. 3. 96 ft.
 WELL'S STATIC WATER LEVEL: 45 ft. below land surface measured on mo/day/yr 3/27/81
 Pump test data: Well water was _____ ft. after _____ hours pumping _____ gpm
 Est. Yield 30 gpm: Well water was _____ ft. after _____ hours pumping _____ gpm
 Bore Hole Diameter: 8 1/4 in. to 4 1/2 ft., and 6 1/4 in. to 12 1/2 ft.
 WELL WATER TO BE USED AS:
 1 Domestic 3 Feedlot 6 Oil field water supply 9 Dewatering 12 Other (Specify below)
 2 Irrigation 4 Industrial 7 Lawn and garden only 10 Observation well
 Was a chemical/bacteriological sample submitted to Department? Yes _____ (No) _____; If yes, mo/day/yr sample was submitted _____
 Water Well Disinfected? Yes No

5] TYPE OF BLANK CASING USED:
 1 Steel 3 RMP (SR) 6 Asbestos-Cement 9 Other (specify below) Welded _____
 2 PVC 4 ABS 7 Fiberglass _____ Threaded _____
 Blank casing diameter 6 in. to 4 1/2 ft., Dia. 5 1/2 in. to 12 1/2 ft., Dia. _____ in. to _____ ft.
 Casing height above land surface 18 in., weight Sch 40 lbs./ft. Wall thickness or gauge No. Sch 400

TYPE OF SCREEN OR PERFORATION MATERIAL:
 1 Steel 3 Stainless steel 5 Fiberglass 8 RMP (SR) 11 Other (specify) _____
 2 Brass 4 Galvanized steel 6 Concrete tile 9 ABS 12 None used (open hole)

SCREEN OR PERFORATION OPENINGS ARE:
 1 Continuous slot 2 Mill slot 6 Wire wrapped 9 Drilled holes
 2 Louvered shutter 4 Key punched 7 Torch cut 10 Other (specify) _____

SCREEN-PERFORATED INTERVALS: From 110 ft. to 120 ft., From _____ ft. to _____ ft.
 From _____ ft. to _____ ft., From _____ ft. to _____ ft.
 GRAVEL PACK INTERVALS: From _____ ft. to _____ ft., From _____ ft. to _____ ft.
 From _____ ft. to _____ ft., From _____ ft. to _____ ft.

6] GROUT MATERIAL: 1 Neat cement 2 Cement grout 3 Bentonite 4 Other _____
 Grout Intervals: From 3 ft. to 45 ft., From _____ ft. to _____ ft., From _____ ft. to _____ ft.
 What is the nearest source of possible contamination:
 1 Septic tank 4 Lateral lines 7 Pit privy 10 Livestock pens 14 Abandoned water well
 2 Sewer lines 5 Cess pool 8 Sewage lagoon 11 Fuel storage 15 Oil well/Gas well
 3 Watertight sewer lines 6 Seepage pit 9 Feedyard 12 Fertilizer storage 16 Other (specify below)
 13 Insecticide storage _____
 Direction from well? NE How many feet? 100

FROM	TO	LITHOLOGIC LOG	FROM	TO	LITHOLOGIC LOG
0	45	Soil & Clay	0		
45	96	grey Sanded shale	19		
96	110	grey Sanded			
110	121	White Sand	05		
121	124	Shale	19		

7] CONTRACTOR'S OR LANDOWNER'S CERTIFICATION: This water well was (1) constructed, (2) reconstructed, or (3) plugged under my jurisdiction and was completed on (mo/day/year) 3/27/81 and this record is true to the best of my knowledge and belief. Kansas Water Well Contractor's License No. 391 This Water Well Record was completed on (mo/day/yr) 3/31/81 under the business name of Royce Swank Drilling by (signature) Royce Swank
 INSTRUCTIONS: Use typewriter or ball point pen, PLEASE PRESS FIRMLY and PRINT clearly. Please fill in blanks, underline or circle the correct answers. Send top three copies to Kansas Department of Health and Environment, Division of Environment, Environmental Geology Section, Topeka, KS 66620. Send one to WATER WELL OWNER and retain one for your records.