


1 LOCATION OF WATER WELL: Fraction NW 1/4 NW 1/4 NE 1/4 Section Number 6 Township Number T 16 S Range Number R 18 E
 County: Franklin
 Distance and direction from nearest town or city street address of well if located within city?
6 North 1/2 West Pomona

2 WATER WELL OWNER: Appomoose grade School
 RR#, St. Address, Box #: Pomona Kan, 66096 Board of Agriculture, Division of Water Resources
 City, State, ZIP Code: Pomona Kan, 66096 Application Number:

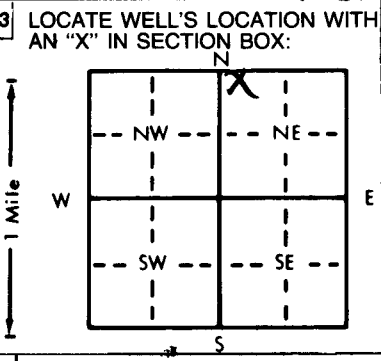

4 DEPTH OF COMPLETED WELL: 210 ft. ELEVATION: ft.
 Depth(s) Groundwater Encountered 70 ft. 2. 140 ft. 3. ft.
 WELL'S STATIC WATER LEVEL 70 ft. below land surface measured on mo/day/yr Nov, 1982
 Pump test data: Well water was ft. after hours pumping gpm
 Est. Yield 25 gpm: Well water was ft. after hours pumping gpm
 Bore Hole Diameter: 10 in. to 138 ft., and 6 1/4 in. to 210 ft.
 WELL WATER TO BE USED AS: 5 Public water supply 8 Air conditioning 11 Injection well
 1 Domestic 3 Feedlot 6 Oil field water supply 9 Dewatering 12 Other (Specify below)
 2 Irrigation 4 Industrial 7 Lawn and garden only 10 Observation well
 Was a chemical/bacteriological sample submitted to Department? Yes X No; If yes, mo/day/yr sample was submitted Nov 1982
 Water Well Disinfected? Yes X No

5 TYPE OF BLANK CASING USED:
 Steel 3 RMP (SR) 8 Concrete tile CASING JOINTS: Welded Clamped
 2 PVC 4 ABS 6 Asbestos-Cement 9 Other (specify below) Threaded
 7 Fiberglass
 Blank casing diameter 5 in. to 140 ft., Dia in. to ft., Dia in. to ft.
 Casing height above land surface 36 in., weight Sch 40 lbs./ft. Wall thickness or gauge No. Sch 40
 TYPE OF SCREEN OR PERFORATION MATERIAL:
 1 Steel 3 Stainless steel 5 Fiberglass 8 RMP (SR) 10 Asbestos-cement
 2 Brass 4 Galvanized steel 6 Concrete tile 9 ABS 12 None used (open hole)
 SCREEN OR PERFORATION OPENINGS ARE:
 1 Continuous slot 3 Mill slot 5 Gauzed wrapped 8 Saw cut 11 None (open hole)
 2 Louvered shutter 4 Key punched 6 Wire wrapped 9 Drilled holes
 7 Torch cut 10 Other (specify)
 SCREEN-PERFORATED INTERVALS: From NONE ft. to ft., From ft. to ft.
 GRAVEL PACK INTERVALS: From NONE ft. to ft., From ft. to ft.

6 GROUT MATERIAL: 1 Neat cement 2 Cement grout 3 Bentonite 4 Other
 Grout Intervals: From 140 ft. to ft., From ft. to ft., From ft. to ft.
 What is the nearest source of possible contamination:
 Septic tank 4 Lateral lines 7 Pit privy 10 Livestock pens 14 Abandoned water well
 2 Sewer lines 5 Cess pool 8 Sewage lagoon 11 Fuel storage 15 Oil well/Gas well
 3 Watertight sewer lines 6 Seepage pit 9 Feedyard 12 Fertilizer storage 16 Other (specify below)
 13 Insecticide storage
 Direction from well? East How many feet? 150

FROM	TO	LITHOLOGIC LOG	FROM	TO	LITHOLOGIC LOG
0	6	Soil			
6	15	Shelly Rock			
15	26	Clay			
26	29	Lime			
29	40	Shald			
40	48	Lime			
48	33	Black Shald			
33	36	Lime			
36	78	Shald			
78	81	Lime			
81	91	Shald			
91	100	Lime			
100	138	Blue Shald			
138	140	Lime			
140	210	White Sand			

7 CONTRACTOR'S OR LANDOWNER'S CERTIFICATION: This water well was (1) constructed, (2) reconstructed, or (3) plugged under my jurisdiction and was completed on (mo/day/year) Nov 1982 and this record is true to the best of my knowledge and belief. Kansas Water Well Contractor's License No. 371 This Water Well Record was completed on (mo/day/yr) 8-8-83 under the business name of Roxae Swant Drilling by (signature) Roxae Swant
 INSTRUCTIONS: Use typewriter or ball point pen, PLEASE PRESS FIRMLY and PRINT clearly. Please fill in blanks, underline or circle the correct answers. Send top three copies to Kansas Department of Health and Environment, Division of Environment, Environmental Geology Section, Topeka, KS 66620. Send one to WATER WELL OWNER and retain one for your records.