


1 LOCATION OF WATER WELL: County: Franklin Fraction: NW 1/4 NW 1/4 NW 1/4 Section Number: 7 Township Number: T 16 S Range Number: R 18 EW

Distance and direction from nearest town or city street address of well if located within city? 5 miles North + 1 West of Pomona, KS.

2 WATER WELL OWNER: Marty Criqui Board of Agriculture, Division of Water Resources
 RR#, St. Address, Box #: Rt. 1 Box 26 Application Number:
 City, State, ZIP Code: Queenemo, KS. 66528

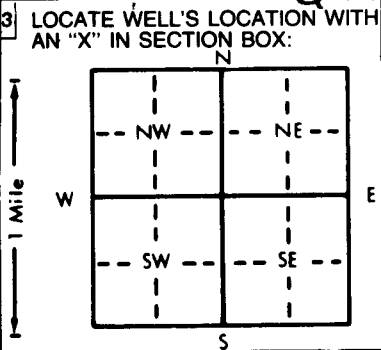

4 DEPTH OF COMPLETED WELL: 175 ft. ELEVATION:
 Depth(s) Groundwater Encountered: 1. 104-175 ft. 2. ft. 3. ft.
 WELL'S STATIC WATER LEVEL: 64 ft. below land surface measured on 6-14-94
 Pump test data: Well water was ft. after hours pumping gpm
 Est. Yield: 35 gpm; Well water was ft. after hours pumping gpm
 Bore Hole Diameter: 8 3/4 in. to 20 ft., and 7 7/8 in. to 175 ft.
 WELL WATER TO BE USED AS:
 1 Domestic 3 Feedlot 6 Oil field water supply 9 Dewatering 12 Other (Specify below)
 2 Irrigation 4 Industrial 7 Lawn and garden only 10 Monitoring well
 Was a chemical/bacteriological sample submitted to Department? Yes.....No.....; If yes, mo/day/yr sample was submitted
 Water Well Disinfected? Yes No

5 TYPE OF BLANK CASING USED:
 1 Steel 3 RMP (SR) 5 Wrought iron 6 Asbestos-Cement 8 Concrete tile 9 Other (specify below) CASING JOINTS: Glued Clamped
 2 PVC 4 ABS 7 Fiberglass 10 Asbestos-cement
 Blank casing diameter: 5 in. to 155 ft., Dia. in. to ft., Dia. in. to ft.
 Casing height above land surface: 36 in., weight lbs./ft. Wall thickness or gauge No. 200#
 TYPE OF SCREEN OR PERFORATION MATERIAL:
 1 Steel 3 Stainless steel 5 Fiberglass 7 PVC 10 Asbestos-cement
 2 Brass 4 Galvanized steel 6 Concrete tile 8 RMP (SR) 11 Other (specify) 12 None used (open hole)
 SCREEN OR PERFORATION OPENINGS ARE:
 1 Continuous slot 3 Mill slot 5 Gauzed wrapped 8 Saw cut 11 None (open hole)
 2 Louvered shutter 4 Key punched 6 Wire wrapped 9 Drilled holes
 SCREEN-PERFORATED INTERVALS: From 155 ft. to 175 ft., From ft. to ft.
 GRAVEL PACK INTERVALS: From 175 ft. to 30 ft., From ft. to ft.

6 GROUT MATERIAL: 1 Neat cement 2 Cement grout 3 Bentonite 4 Other
 Grout Intervals: From 30 ft. to 0 ft., From ft. to ft., From ft. to ft.
 What is the nearest source of possible contamination: NONE AT THE TIME
 1 Septic tank 4 Lateral lines 7 Pit privy 10 Livestock pens 14 Abandoned water well
 2 Sewer lines 5 Cess pool 8 Sewage lagoon 11 Fuel storage 15 Oil well/Gas well
 3 Watertight sewer lines 6 Seepage pit 9 Feedyard 12 Fertilizer storage 16 Other (specify below)
 13 Insecticide storage

Direction from well? How many feet?

FROM	TO	LITHOLOGIC LOG	FROM	TO	PLUGGING INTERVALS
0	25	Soil & Clay			
25	81	Shale			
81	84	SAND - fine grained			
84	94	SAND & Shale Laminated			
94	96	SAND - fine grained			
96	104	SAND & Shale Laminated			
104	175	SAND - large grained, water			

7 CONTRACTOR'S OR LANDOWNER'S CERTIFICATION: This water well was (1) constructed, (2) reconstructed, or (3) plugged under my jurisdiction and was completed on (mo/day/year) 6-14-94 and this record is true to the best of my knowledge and belief. Kansas Water Well Contractor's License No. 561 This Water Well Record was completed on (mo/day/yr) 6-14-94 under the business name of EVANS Energy Dev. Inc. by (signature) [Signature]

INSTRUCTIONS: Use typewriter or ball point pen. PLEASE PRESS FIRMLY and PRINT clearly. Please fill in blanks, underline or circle the correct answers. Send top three copies to Kansas Department of Health and Environment, Bureau of Water, Topeka, Kansas 66620-0001. Telephone: 913-296-5545. Send one to WATER WELL OWNER and retain one for your records.