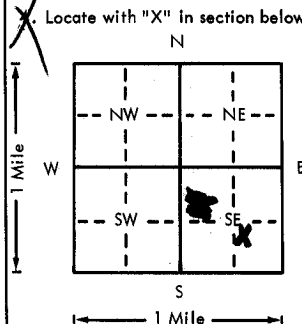


USE TYPEWRITER OR BALL POINT PEN-PRESS FIRMLY, PRINT CLEARLY.

WATER WELL RECORD
KSA 82a-1201-1215

Kansas Department of Health and Environment-Division of Environment
(Water well Contractors)
Topeka, Kansas 66620

1. Location of well:	County Franklin	Fraction NW 1/4 SE 1/4 SE 1/4	Section number 8	Township number T 16 S R 18 E/W	Range number 18
2. Distance and direction from nearest town or city: Street address of well location if in city:		3. Owner of well: John Stone R.R. or street: RRI City, state, zip code: Pomona, Kansas 66076			
4. Locate with "X" in section below: Sketch map: 		6. Bore hole dia. 6 in. Completion date 3-9-79 Well depth 170 ft. 9" to 20" 7. <input checked="" type="checkbox"/> Cable tool <input type="checkbox"/> Rotary <input type="checkbox"/> Driven <input type="checkbox"/> Dug <input type="checkbox"/> Hollow rod <input type="checkbox"/> Jetted <input type="checkbox"/> Bored <input type="checkbox"/> Reverse rotary 8. Use: <input checked="" type="checkbox"/> Domestic <input type="checkbox"/> Public supply <input type="checkbox"/> Industry <input type="checkbox"/> Irrigation <input type="checkbox"/> Air conditioning <input type="checkbox"/> Stock <input type="checkbox"/> Lawn <input type="checkbox"/> Oil field water <input type="checkbox"/> Other 9. Casing: Material _____ Height: Above or below Threaded _____ Welded _____ Surface 18 in. RMP _____ PVC <input checked="" type="checkbox"/> Weight sch 40 lbs./ft. Dia. 5 1/2 in. to 170 ft. depth Wall Thickness: inches or Dia. 2 1/2 in. to 20 ft. depth gage No. sch 40			
5. Type and color of material		From	To		
soil		0	4	10. Screen: Manufacturer's name Crown Line	
lime		4	15	Type Pvc Dia. 5 1/2	
black shald		15	18	Slot/gauze 3/8 Length 30	
lime		18	22	Set between 140 ft. and 170 ft.	
shald		22	80	Gravel pack? no Size range of material _____	
lime		80	83	11. Static water level: 80 ft. below land surface Date 3-9-79	
sanded shald		83	130	12. Pumping level below land surfaces: _____ ft. after _____ hrs. pumping _____ g.p.m. _____ ft. after _____ hrs. pumping _____ g.p.m. Estimated maximum yield 15 g.p.m.	
lime		130	132	13. Water sample submitted: _____ mo./day/yr. Yes _____ No _____ Date _____	
white sand		132	170	14. Well head completion: <input checked="" type="checkbox"/> Pitless adapter _____ Inches above grade	
				15. Well grouted? _____ With: <input checked="" type="checkbox"/> Neat cement _____ Bentonite _____ Concrete _____ Depth: From 3 ft. to 0 ft.	
				16. Nearest source of possible contamination: ft. _____ Direction _____ Type _____ Well disinfected upon completion? <input checked="" type="checkbox"/> Yes _____ No _____	
				17. Pump: <input checked="" type="checkbox"/> Not installed Manufacturer's name _____ Model number _____ HP _____ Volts _____ Length of drop pipe _____ ft. capacity _____ g.p.m. Type: <input type="checkbox"/> Submersible <input type="checkbox"/> Turbine <input type="checkbox"/> Jet <input type="checkbox"/> Reciprocating <input type="checkbox"/> Centrifugal <input type="checkbox"/> Other	
18. Elevation: 1080		19. Remarks: Drill in a pasture. No contamination as of let.		20. Water well contractor's certification: This well was drilled under my jurisdiction and this report is true to the best of my knowledge and belief. Royce Swank Drilling 371 Business name _____ License No. _____ Address: Ottawa, Kansas 66067 Signed: Royce Swank Date 3-20-79 Authorized representative	

T 16 S R 18 E/W
 NW 1/4 SE 1/4