


1 LOCATION OF WATER WELL: County: Franklin 05^a Fraction: NE 1/4 NE 1/4 NE 1/4 Section Number: 17 Township Number: T 16 S Range Number: R 18 E

Distance and direction from nearest town or city street address of well if located within city? Pomona
1/2 north 1/2 east

2 WATER WELL OWNER: Dave Bowman
RR#, St. Address, Box #: _____ Board of Agriculture, Division of Water Resources
City, State, ZIP Code: Pomona Kan 66067 Application Number: _____

3 LOCATE WELL'S LOCATION WITH AN "X" IN SECTION BOX:

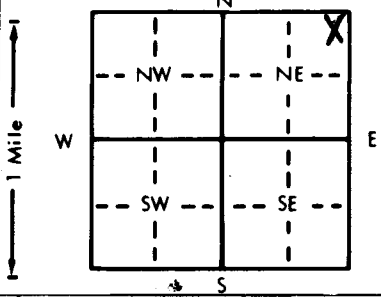

4 DEPTH OF COMPLETED WELL: 225 ft. ELEVATION: _____
Depth(s) Groundwater Encountered: 1 185 ft. 2. _____ ft. 3. _____ ft.
WELL'S STATIC WATER LEVEL: 160 ft. below land surface measured on mo/day/yr _____
Pump test data: Well water was _____ ft. after _____ hours pumping _____ gpm
Est. Yield: 25 gpm; Well water was _____ ft. after _____ hours pumping _____ gpm
Bore Hole Diameter: 6 1/4 in. to 2 1/2 in. to _____ in. to _____ in. to _____ ft.
WELL WATER TO BE USED AS:
 1 Domestic 3 Feedlot 6 Oil field water supply 9 Dewatering 12 Other (Specify below)
 2 Irrigation 4 Industrial 7 Lawn and garden only 10 Observation well
Was a chemical/bacteriological sample submitted to Department? Yes No ; If yes, mo/day/yr sample was submitted _____
Water Well Disinfected? Yes No

5 TYPE OF BLANK CASING USED:
1 Steel 3 RMP (SR) 5 Wrought iron 8 Concrete tile CASING JOINTS: Gried Clamped
 2 PVC 5 1/2 ABS 6 Asbestos-Cement 9 Other (specify below) Welded
Blank casing diameter: 5 1/2 in. to 18 1/2 ft. Dia _____ in. to _____ ft. Dia _____ in. to _____ ft.
Casing height above land surface: 18 in., weight: 5ch 40 lbs./ft. Wall thickness or gauge No. 8ch 40

TYPE OF SCREEN OR PERFORATION MATERIAL:
1 Steel 3 Stainless steel 5 Fiberglass 7 PVC 10 Asbestos-cement
2 Brass 4 Galvanized steel 6 Concrete tile 8 RMP (SR) 11 Other (specify) _____
3 Fiberglass 9 ABS 12 None used (open hole) _____

SCREEN OR PERFORATION OPENINGS ARE:
1 Continuous slot 3 Mill slot 5 Gauzed wrapped 8 Saw cut 11 None (open hole)
2 Louvered shutter 4 Key punched 6 Wire wrapped 9 Drilled holes
3 Torch cut 10 Other (specify) _____

SCREEN-PERFORATED INTERVALS: From 185 ft. to 225 ft., From _____ ft. to _____ ft.
GRAVEL PACK INTERVALS: From _____ ft. to _____ ft., From _____ ft. to _____ ft.

6 GROUT MATERIAL: Neat cement 2 Cement grout 3 Bentonite 4 Other _____
Grout Intervals: From 3 ft. to 20 ft., From _____ ft. to _____ ft., From _____ ft. to _____ ft.
What is the nearest source of possible contamination:
1 Septic tank 4 Lateral lines 7 Pit privy 10 Livestock pens 14 Abandoned water well
2 Sewer lines 5 Cess pool 8 Sewage lagoon 11 Fuel storage 15 Oil well/Gas well
3 Watertight sewer lines 6 Seepage pit 9 Feedyard 12 Fertilizer storage 16 Other (specify below) _____
13 Insecticide storage _____
Direction from well? West How many feet? 50

FROM	TO	LITHOLOGIC LOG	FROM	TO	LITHOLOGIC LOG
0	2	0/5 Soil			
2	10	20 Shelly Rock			
10	50	50 Ashald			
50	68	68 20 Lime			
68	101	101 19 Ashald			
101	131	131 20 Lime			
131	162	162 19 Ashald			
162	185	185 grey Sand			
185	225	225 white Sand			

7 CONTRACTOR'S OR LANDOWNER'S CERTIFICATION: This water well was constructed reconstructed, or plugged under my jurisdiction and was completed on (mo/day/year) April 28 89 and this record is true to the best of my knowledge and belief. Kansas Water Well Contractor's License No. 391 This Water Well Record was completed on (mo/day/yr) April 28 89 under the business name of Royce Swank Drilling by (signature) Royce Swank

INSTRUCTIONS: Use typewriter or ball point pen, PLEASE PRESS FIRMLY and PRINT clearly. Please fill in blanks, underline or circle the correct answers. Send top three copies to Kansas Department of Health and Environment, Division of Environment, Environmental Geology Section, Topeka, KS 66620. Send one to WATER WELL OWNER and retain one for your records.

DP