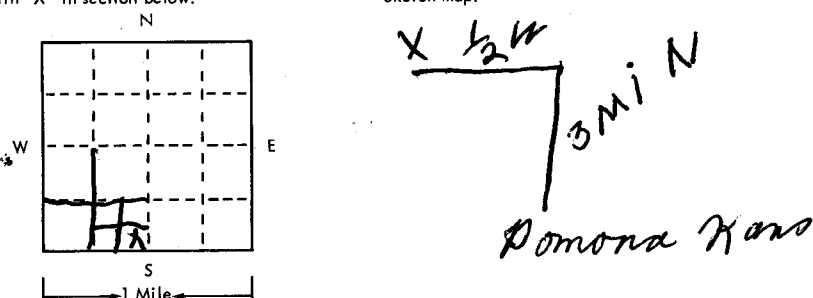


USE TYPEWRITER OR BALL POINT PEN—PRESS FIRMLY, PRINT CLEARLY.

WATER WELL RECORD
KSA 82a-1201-1215

T R EW sec 1/4 1/4 1/4 No.

Kansas State Dept. Of Health
(Water Well Contractors)
Forbes-Bldg. 740
Topeka, Kansas 66620

1 Location of well:	County FRANKLIN	Township name APP	Fraction SE 1/4 SE 1/4 SW 1/4	Section number 18	Town number T16S	Range number R18E
Distance and direction from nearest town or city:	3 MI N & 1/2 W			3 Owner of well:	MRS. RAWLEIG THOMPSON	
Street address of well location if in city:	POMONA KANSAS			Address:	OTTAWA KANSAS R4	
Locate with "X" in section below:	Sketch map: 			4 Well depth: _____ ft. Date of completion _____ Well diameter _____ in.		
2 Old drilled well plugged Record. CEMENT From 6' to 18' GRAVEL " 18 " 212" CEMENT 212 - 215' GRAVEL 215 - 235'	Color of material	From	To	5 <input type="checkbox"/> Cable tool <input type="checkbox"/> Rotary <input type="checkbox"/> Driven <input type="checkbox"/> Dug <input type="checkbox"/> Hollow rod <input type="checkbox"/> Jetted <input type="checkbox"/> Bored <input type="checkbox"/> Reverse rotary		
				6 Use: <input type="checkbox"/> Domestic <input type="checkbox"/> Public supply <input type="checkbox"/> Industry <input type="checkbox"/> Irrigation <input type="checkbox"/> Air conditioning <input type="checkbox"/> Commercial <input type="checkbox"/> Test well <input type="checkbox"/> _____		
				7 Casing: Material _____ Height: above/below _____ Threaded <input type="checkbox"/> Welded <input type="checkbox"/> Surface _____ in. Diam. _____ Weight _____ lbs./ft. _____ _____ in. to _____ ft. depth Drive shoe? <input type="checkbox"/> Yes <input type="checkbox"/> No _____ in. to _____ ft. depth		
				8 Screen: Manufacturer _____ Type _____ Dia. _____ Slot/gauze _____ Length _____ Set between _____ ft. and _____ ft. _____ Fittings: Gravel pack <input type="checkbox"/> Yes <input type="checkbox"/> No Size range of material _____		
				9 Static water level: _____ ft. below land surface Date _____		
				10 Pumping level below land surfaces: _____ ft. after _____ hrs. pumping _____ g.p.m. _____ ft. after _____ hrs. pumping _____ g.p.m. Estimated maximum yield _____ g.p.m.		
				11 Water sample submitted: <input type="checkbox"/> Yes <input type="checkbox"/> No Date _____		
				12 Well head completion: <input type="checkbox"/> Pitless adapter <input type="checkbox"/> Inches above grade		
				13 Well grouted? <input type="checkbox"/> Yes <input type="checkbox"/> No <input type="checkbox"/> Neat cement <input type="checkbox"/> Bentonite <input type="checkbox"/> _____ Depth: From _____ ft. to _____ ft.		
				14 Nearest source of possible contamination: ft. _____ Direction _____ Type _____ Well disinfected upon completion? <input type="checkbox"/> Yes <input type="checkbox"/> No		
			15 Pump: <input type="checkbox"/> Not installed Manufacturer's name _____ Model number _____ HP _____ Volts _____ Length of drop pipe _____ ft. capacity _____ g.p.m. Type: <input type="checkbox"/> Submersible <input type="checkbox"/> Turbine <input type="checkbox"/> Jet <input type="checkbox"/> Reciprocating <input type="checkbox"/> Centrifugal <input type="checkbox"/> Other			
(use a second sheet if needed)						
16 Remarks: elevation 1075' Topography: <input type="checkbox"/> Hill <input type="checkbox"/> Slope <input checked="" type="checkbox"/> Upland <input type="checkbox"/> Valley				17 Water well contractor's certification: This well was drilled under my jurisdiction and this report is true to the best of my knowledge and belief. EDGAR SWANK 134 Business name _____ License No. _____ Address OTTAWA KANSAS Signed Edgar Swank Date 4-21-75 Authorized representative		

Forward the white, blue and pink copies to the Kansas State Dept. Of Health.

Form WWC-5