


1 LOCATION OF WATER WELL: County: Franklin Fraction: NW 1/4 NW 1/4 ME 1/4 Section Number: 20 Township Number: T 16 S Range Number: R 18 EW

Distance and direction from nearest town or city street address of well if located within city?  
3 north 1/2 east 68 + Pomona Kans

2 WATER WELL OWNER: Jim Cain  
 RR#, St. Address, Box #: Pomona Kans. Board of Agriculture, Division of Water Resources  
 City, State, ZIP Code: Pomona Kans. Application Number:

3 LOCATE WELL'S LOCATION WITH AN "X" IN SECTION BOX:

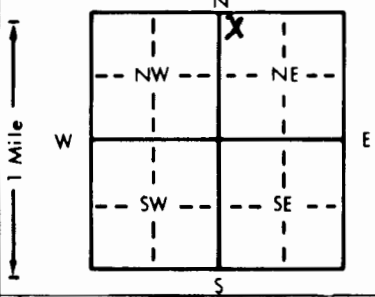

4 DEPTH OF COMPLETED WELL: 215 ft. ELEVATION:

Depth(s) Groundwater Encountered 1. 193 ft. 2. ft. 3. ft.  
 WELL'S STATIC WATER LEVEL: 145 ft. below land surface measured on mo/day/yr 10-2-90  
 Pump test data: Well water was ft. after hours pumping gpm  
 Est. Yield 20+ gpm: Well water was ft. after hours pumping gpm  
 Bore Hole Diameter: 9 in. to 20 ft., and 6 3/4 in. to 215 ft.  
 WELL WATER TO BE USED AS:  
 Domestic 3 Feedlot 6 Oil field water supply 9 Dewatering 12 Other (Specify below)  
 2 Irrigation 4 Industrial 7 Lawn and garden only 10 Monitoring well  
 Was a chemical/bacteriological sample submitted to Department? Yes No  If yes, mo/day/yr sample was submitted  
 Water Well Disinfected? Yes  No

5 TYPE OF BLANK CASING USED: 5 Wrought iron 8 Concrete tile CASING JOINTS: Glued  Clamped  
 1 Steel 3 RMP (SR) 6 Asbestos-Cement 9 Other (specify below) Welded  
 PVC 4 ABS 7 Fiberglass Threaded

Blank casing diameter: 5 in. to 195 ft., Dia. in. to in. to in. to in. to  
 Casing height above land surface: 24 in., weight Sch 40 lbs./ft. Wall thickness or gauge No. Sch 40

TYPE OF SCREEN OR PERFORATION MATERIAL:  
 1 Steel 3 Stainless steel 5 Fiberglass 8 RMP (SR) 10 Asbestos-cement  
 2 Brass 4 Galvanized steel 6 Concrete tile 9 ABS 11 Other (specify)  
 PVC 12 None used (open hole)

SCREEN OR PERFORATION OPENINGS ARE:  
 1 Continuous slot  Mill slot 5 Gauzed wrapped 8 Saw cut 11 None (open hole)  
 2 Louvered shutter 4 Key punched 6 Wire wrapped 9 Drilled holes  
 7 Torch cut 10 Other (specify)

SCREEN-PERFORATED INTERVALS: From 195 ft. to 215 ft., From ft. to ft., From ft. to ft., From ft. to ft.  
 GRAVEL PACK INTERVALS: From ft. to ft., From ft. to ft., From ft. to ft., From ft. to ft.

6 GROUT MATERIAL:  Neat cement 2 Cement grout 3 Bentonite 4 Other  
 Grout intervals: From 0.3 ft. to 20 ft., From ft. to ft., From ft. to ft., From ft. to ft.

What is the nearest source of possible contamination:  
 Septic tank 4 Lateral lines 7 Pit privy 11 Fuel storage 14 Abandoned water well  
 2 Sewer lines 5 Cess pool 8 Sewage lagoon 12 Fertilizer storage 15 Oil well/Gas well  
 3 Watertight sewer lines 6 Seepage pit 9 Feedyard 13 Insecticide storage 16 Other (specify below)

Direction from well? South How many feet? 100

FROM	TO	LITHOLOGIC LOG	FROM	TO	PLUGGING INTERVALS
0	9	Soil			
9	10	Shelly rock			
10	63	Shale			
63	75	Lime			
75	86	Shale Black			
86	90	Lime			
90	130	Shale			
130	193	Sanded gray shale			
193	215	white sand. stone			

7 CONTRACTOR'S OR LANDOWNER'S CERTIFICATION: This water well was  constructed, (2) reconstructed, or (3) plugged under my jurisdiction and was completed on (mo/day/year) 10-2-90 and this record is true to the best of my knowledge and belief. Kansas Water Well Contractor's License No. 486 This Water Well Record was completed on (mo/day/yr) 10-2-90 under the business name of Edgar Swank well Drilling by (signature) Edgar Swank