

CORRECTION(S) TO WATER WELL RECORD (WWC-5)

(to rectify lacking or incorrect information)

County: Franklin

Location listed as:

Location changed to:

Section-Township-Range: \_\_\_\_\_

22-16S-18E

Fraction ( 1/4 1/4 1/4): \_\_\_\_\_

SE SE SE

Other changes: Initial statements: 2 1/2 East 1 1/2 North

Changed to: From Pomona: 2 1/2 East, 1 1/2 North

Comments: \_\_\_\_\_

verification method: Written & legal descriptions, position on plat map, and Pomona & Ottawa NW 1:24,000 topo maps.

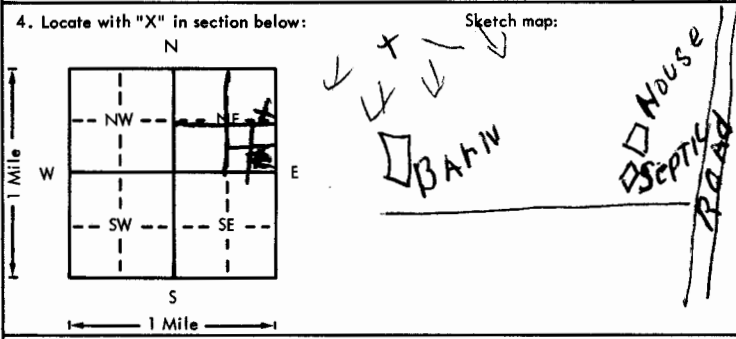
initials: DRJ date: 3/9/2004

submitted by: Kansas Geological Survey, Data Resources Library, 1930 Constant Ave., Lawrence, KS 66047-3726  
to: Kansas Dept of Health & Environment, Bureau of Water, 1000 SW Jackson, Suite 420, Topeka, KS 66612-1367.

USE TYPEWRITER OR BALL POINT PEN-PRESS FIRMLY, PRINT CLEARLY.

WATER WELL RECORD  
KSA 82a-1201-1215

Kansas Department of Health and Environment-Division of Environment (Water well Contractors) Topeka, Kansas 66620

1. Location of well: County <b>FRANKLIN</b> Fraction <b>SE 1/4 NE 1/4 NE 1/4</b> Section number <b>23</b> Township number <b>T 16 S R 18 E/W</b> Range number																						
2. Distance and direction from nearest town or city: <b>2 1/2 E 2 1/4 N</b> Street address of well location if in city: <b>RR 1 BAMA A KAN.</b> 3. Owner of well: <b>W.E. CRAWFORD</b> R.R. or street: <b>RR 1</b> City, state, zip code: <b>ROMONA KANS. 66067</b>																						
4. Locate with "X" in section below: Sketch map: 																						
6. Bore hole dia. <b>6 1/4</b> in. Completion date <b>2-5-76</b> Well depth <b>200</b> ft. <b>18' 9 1/2"</b>																						
7. <input checked="" type="checkbox"/> Cable tool <input type="checkbox"/> Rotary <input type="checkbox"/> Driven <input type="checkbox"/> Dug <input type="checkbox"/> Hollow rod <input type="checkbox"/> Jetted <input type="checkbox"/> Bored <input type="checkbox"/> Reverse rotary																						
8. Use: <input type="checkbox"/> Domestic <input type="checkbox"/> Public supply <input type="checkbox"/> Industry <input checked="" type="checkbox"/> Irrigation <input type="checkbox"/> Air conditioning <input type="checkbox"/> Stock <input type="checkbox"/> Lawn <input type="checkbox"/> Oil field water <input type="checkbox"/> Other																						
9. Casing: Material <b>PVC</b> Height: Above or below Threading: <input type="checkbox"/> Threaded <input type="checkbox"/> Welded <input type="checkbox"/> Surface <b>12</b> in. RMP: <input type="checkbox"/> PVC <input checked="" type="checkbox"/> Weight <b>305</b> lbs./ft. Dia. <b>6 1/4</b> in. to <b>18</b> ft. depth Wall Thickness: inches or Dia. <input type="checkbox"/> in. to <input type="checkbox"/> ft. depth gage No. <b>255</b>																						
5. Type and color of material																						
<table border="1"> <thead> <tr> <th></th> <th>From</th> <th>To</th> </tr> </thead> <tbody> <tr> <td>Soil</td> <td>0</td> <td>4</td> </tr> <tr> <td>Yellow Sand Rock</td> <td>4</td> <td>18</td> </tr> <tr> <td>grey Shale</td> <td>18</td> <td>101</td> </tr> <tr> <td>Yellow Sand Rock</td> <td>101</td> <td>114</td> </tr> <tr> <td>grey Sand</td> <td>114</td> <td>178</td> </tr> <tr> <td>White Sand</td> <td>178</td> <td>200</td> </tr> </tbody> </table>			From	To	Soil	0	4	Yellow Sand Rock	4	18	grey Shale	18	101	Yellow Sand Rock	101	114	grey Sand	114	178	White Sand	178	200
	From	To																				
Soil	0	4																				
Yellow Sand Rock	4	18																				
grey Shale	18	101																				
Yellow Sand Rock	101	114																				
grey Sand	114	178																				
White Sand	178	200																				
10. Screen: Manufacturer's name _____ Type <b>NONE</b> Dia. _____ Slot/gauze _____ Length _____ Set between _____ ft. and _____ ft. Gravel pack? _____ Size range of material _____																						
11. Static water level: _____ mo./day/yr. <b>100</b> ft. below land surface Date <b>2-5-76</b>																						
12. Pumping level below land surfaces: _____ ft. after _____ hrs. pumping _____ g.p.m. _____ ft. after _____ hrs. pumping _____ g.p.m. Estimated maximum yield <b>30</b> g.p.m.																						
13. Water sample submitted: _____ mo./day/yr. Yes <input type="checkbox"/> No <input checked="" type="checkbox"/> Date _____																						
14. Well head completion: _____ Pitless adapter <b>12</b> Inches above grade																						
15. Well grouted? <input checked="" type="checkbox"/> With: <input checked="" type="checkbox"/> Neat cement <input type="checkbox"/> Bentonite <input type="checkbox"/> Concrete Depth: From <b>0</b> ft. to <b>18</b> ft.																						
16. Nearest source of possible contamination: ft. <b>200</b> Direction <b>S</b> Type <b>BAMA</b> Well disinfected upon completion? <input checked="" type="checkbox"/> Yes <input type="checkbox"/> No																						
17. Pump: <input checked="" type="checkbox"/> Not installed Manufacturer's name _____ Model number _____ HP _____ Volts _____ Length of drop pipe _____ ft. capacity _____ g.p.m. Type: <input type="checkbox"/> Submersible <input type="checkbox"/> Turbine <input type="checkbox"/> Jet <input type="checkbox"/> Reciprocating <input type="checkbox"/> Centrifugal <input type="checkbox"/> Other																						
(Use a second sheet if needed)																						
18. Elevation: Topography: <input type="checkbox"/> Hill <input type="checkbox"/> Slope <input checked="" type="checkbox"/> Upland <input type="checkbox"/> Valley	19. Remarks: <b>Cement slab for pump house will be <del>put</del> buinsh when weather warms.</b>																					
20. Water well contractor's certification: This well was drilled under my jurisdiction and this report is true to the best of my knowledge and belief. <b>SWANK DRILLING</b> Business name License No. Address <b>PH OTTAWA KANS.</b> Signed <b>Edgar Swank</b> Date <b>2-7-76</b> Authorized representative																						

T 16 R 18 E W 22 Sec 22 SE NE NE