


1 LOCATION OF WATER WELL: County: **FRANKLIN** Fraction: **NE 1/4 SE 1/4** Section Number: **23** Township Number: **T 16 S** Range Number: **R 18 E**

Distance and direction from nearest town or city street address of well if located within city?
2 1/2 MILE NORTH OF RICHTER

2 WATER WELL OWNER: **JOHN POWELL**
 RR#, St. Address, Box #: **1407 DOWNEE RD**
 City, State, ZIP Code: **POMONA, KS 66076**
 Board of Agriculture, Division of Water Resources
 Application Number:

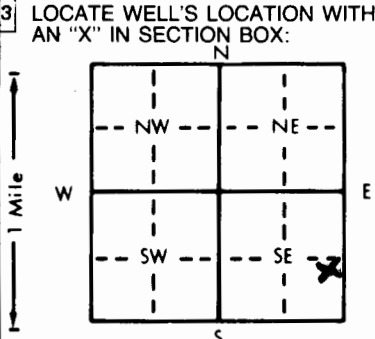

4 DEPTH OF COMPLETED WELL: **155** ft. ELEVATION:
 Depth(s) Groundwater Encountered 1. **30** ft. 2. **125** ft. 3. **6-11-91** ft.
 WELL'S STATIC WATER LEVEL: **70** ft. below land surface measured on mo/day/yr
 Pump test data: Well water was _____ ft. after _____ hours pumping _____ gpm
 Est. Yield: **7** gpm: Well water was _____ ft. after _____ hours pumping _____ gpm
 Bore Hole Diameter: **9** in. to **31** ft., and **6 1/4** in. to **155** ft.
 WELL WATER TO BE USED AS:
 Domestic 3 Feedlot 6 Oil field water supply 9 Dewatering 12 Other (Specify below)
 2 Irrigation 4 Industrial 7 Lawn and garden only 10 Monitoring well
 Was a chemical/bacteriological sample submitted to Department? Yes _____ No If yes, mo/day/yr sample was sub-
 mitted Water Well Disinfected? Yes No

5 TYPE OF BLANK CASING USED:
 1 Steel 3 RMP (SR) 5 Wrought iron 8 Concrete tile CASING JOINTS: Glued Clamped _____
 2 PVC 4 ABS 6 Asbestos-Cement 9 Other (specify below) Welded _____
 7 Fiberglass Threaded _____
 Blank casing diameter: **6 1/2** in. to **38** ft. Dia _____ in. to _____ ft. Dia _____ in. to _____ ft.
 Casing height above land surface: **pump house** weight _____ lbs./ft. Wall thickness or gauge No. **50R-26**
 TYPE OF SCREEN OR PERFORATION MATERIAL:
 1 Steel 3 Stainless steel 5 Fiberglass 8 RMP (SR) 11 Other (specify) **NA**
 2 Brass 4 Galvanized steel 6 Concrete tile 9 ABS 12 None used (open hole)
 SCREEN OR PERFORATION OPENINGS ARE:
 1 Continuous slot 3 Mill slot 5 Gauzed wrapped 8 Saw cut 11 None (open hole)
 2 Louvered shutter 4 Key punched 6 Wire wrapped 9 Drilled holes
 7 Torch cut 10 Other (specify) **NA**
 SCREEN-PERFORATED INTERVALS: From _____ ft. to _____ ft. From _____ ft. to _____ ft.
 GRAVEL PACK INTERVALS: From _____ ft. to _____ ft. From _____ ft. to _____ ft.

6 GROUT MATERIAL: 1 Neat cement 2 Cement grout 3 Bentonite 4 Other _____
 Grout Intervals: From **8** ft. to **38** ft. From _____ ft. to _____ ft. From _____ ft. to _____ ft.
 What is the nearest source of possible contamination:
 1 Septic tank 4 Lateral lines 7 Pit privy 10 Livestock pens 14 Abandoned water well
 2 Sewer lines 5 Cess pool 8 Sewage lagoon 11 Fuel storage 15 Oil well/Gas well
 3 Watertight sewer lines 6 Seepage pit 9 Feedyard 12 Fertilizer storage 16 Other (specify below)
 13 Insecticide storage
 Direction from well? **NONE AT THIS TIME** How many feet?

DIRECTION FROM WELL?		LITHOLOGIC LOG		PLUGGING INTERVALS	
FROM	TO	FROM	TO	FROM	TO
0	6				
6	10				
10	31				
31	110				
110	125				
125	155				

7 CONTRACTOR'S OR LANDOWNER'S CERTIFICATION: This water well was (1) constructed, (2) reconstructed, or (3) plugged under my jurisdiction and was completed on (mo/day/year) **6-11-91** and this record is true to the best of my knowledge and belief. Kansas Water Well Contractor's License No. **536** This Water Well Record was completed on (mo/day/yr) **6-12-91** under the business name of **Patchew Pump & Well Drilling Inc** by (signature) **Jim E. Patchew**

8420971006-2