


1 LOCATION OF WATER WELL: County: Franklin Fraction: NE 1/4 NE 1/4 SE 1/4 Section Number: 26 Township Number: T 16 S Range Number: R 18 E

Distance and direction from nearest town or city street address of well if located within city?
6 m W of Ottawa

2 WATER WELL OWNER: Reuben Fastnacht
RR#, St. Address, Box #: RR1 Parsona, Kans. 66076
City, State, ZIP Code: RR1 Parsona, Kans. 66076
Board of Agriculture, Division of Water Resources
Application Number:

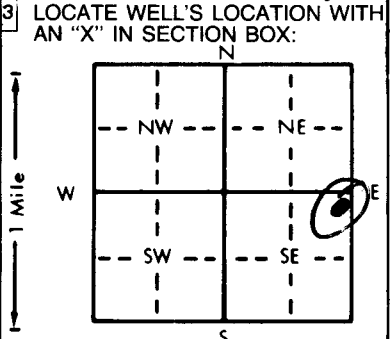

4 DEPTH OF COMPLETED WELL: 130 ft. ELEVATION: 115 ft.
Depth(s) Groundwater Encountered 1. 42 ft. 2. 115 ft. 3. 115 ft.
WELL'S STATIC WATER LEVEL U.O. KNOWN below land surface measured on mo/day/yr 7-13-85
Pump test data: Well water was _____ ft. after _____ hours pumping _____ gpm
Est. Yield 10-12 gpm; Well water was _____ ft. after _____ hours pumping _____ gpm
Bore Hole Diameter: 8" in. to 80' ft., and 6 1/2" in. to 130' ft.
WELL WATER TO BE USED AS:
1 Domestic 3 Feedlot 6 Oil field water supply 9 Dewatering 12 Other (Specify below) _____
2 Irrigation 4 Industrial 7 Lawn and garden only 10 Observation well
Was a chemical/bacteriological sample submitted to Department? Yes _____ No ; If yes, mo/day/yr sample was submitted _____
Water Well Disinfected? Yes No _____

5 TYPE OF BLANK CASING USED:
1 Steel 3 RMP (SR) 5 Wrought iron 8 Concrete tile CASING JOINTS: Glued Clamped _____
2 PVC 4 ABS 6 Asbestos-Cement 9 Other (specify below) _____ Welded _____
Blank casing diameter 5" in. to 51" ft., Dia _____ in. to _____ ft., Dia _____ in. to _____ ft.
Casing height above land surface: 24 in., weight _____ lbs./ft. Wall thickness or gauge No. SDR26
TYPE OF SCREEN OR PERFORATION MATERIAL:
1 Steel 3 Stainless steel 5 Fiberglass 7 PVC 10 Asbestos-cement
2 Brass 4 Galvanized steel 6 Concrete tile 8 RMP (SR) 11 Other (specify) _____
9 ABS 12 None used (open hole) _____
SCREEN OR PERFORATION OPENINGS ARE:
1 Continuous slot 3 Mill slot 5 Gauzed wrapped 8 Saw cut 11 None (open hole)
2 Louvered shutter 4 Key punched 6 Wire wrapped 9 Drilled holes
7 Torch cut 10 Other (specify) _____
SCREEN-PERFORATED INTERVALS: From 51 ft. to 130 ft., From _____ ft. to _____ ft.
GRAVEL PACK INTERVALS: From _____ ft. to _____ ft., From _____ ft. to _____ ft.

6 GROUT MATERIAL: 1 Neat cement 2 Cement grout 3 Bentonite 4 Other _____
Grout Intervals: From 0 ft. to 20 ft., From 42 ft. to 49 ft., From _____ ft. to _____ ft.
What is the nearest source of possible contamination:
1 Septic tank 4 Lateral lines 7 Pit privy 10 Livestock pens 14 Abandoned water well
2 Sewer lines 5 Cess pool 8 Sewage lagoon 11 Fuel storage 15 Oil well/Gas well
3 Watertight sewer lines 6 Seepage pit 9 Feedyard 12 Fertilizer storage 16 Other (specify below) _____
13 Insecticide storage _____
Direction from well? South How many feet? 100

| FROM | TO | LITHOLOGIC LOG | FROM | TO | LITHOLOGIC LOG |
|------|-----|------------------|------|----|----------------|
| 0 | 0 | yellow clay | | | |
| 0 | 42 | sandstone brown | | | |
| 42 | 47 | lime | | | |
| 47 | 60 | sandy shale grey | | | |
| 60 | 62 | lime | | | |
| 62 | 100 | sandstone grey | | | |
| 100 | 115 | sandy shale | | | |
| 115 | 130 | sandstone grey | | | |

7 CONTRACTOR'S OR LANDOWNER'S CERTIFICATION: This water well was (1) constructed (2) reconstructed, or (3) plugged under my jurisdiction and was completed on (mo/day/year) 7-14-85 and this record is true to the best of my knowledge and belief. Kansas Water Well Contractor's License No. 316 This Water Well Record was completed on (mo/day/yr) 7-23-85 under the business name of Robison Drilling by (signature) J. Robison
INSTRUCTIONS: Use typewriter or ball point pen, PLEASE PRESS FIRMLY and PRINT clearly. Please fill in blanks, underline or circle the correct answers. Send top three copies to Kansas Department of Health and Environment, Division of Environment, Environmental Geology Section, Topeka, KS 66620. Send one to WATER WELL OWNER and retain one for your records.