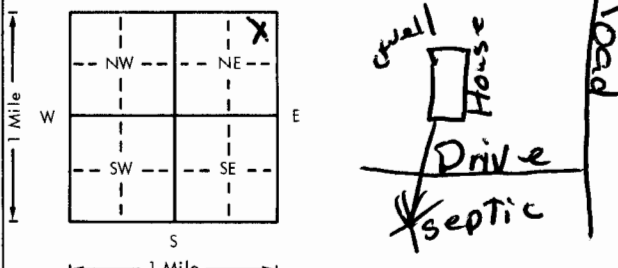


USE TYPEWRITER OR BALL
POINT PEN-PRESS FIRMLY,
PRINT CLEARLY.

WATER WELL RECORD
KSA 82a-1201-1215

Kansas Department of Health and
Environment-Division of Environment
(Water well Contractors)
Topeka, Kansas 66620

| | | | | | | |
|---|--|---|---|--|----------------------------------|--|
| 1. Location of well: | | County Franklin | Fraction NE 1/4 NE 1/4 NE 1/4 | Section number 29 | Township number T 16 S | Range number R 18 E |
| 2. Distance and direction from nearest town or city: | | Street address of well location if in city: | | 3. Owner of well: Mark Frieden R.R. or street: RR1 City, state, zip code: Pomona, Kan. 66076 | | |
| 4. Locate with "X" in section below: | | Sketch map: | | 6. Bore hole dia. 6 1/2 in. Completion date 11-22-78 Well depth 145 ft. 9" to 20 | | |
|  | | | | 7. <input checked="" type="checkbox"/> Cable tool <input type="checkbox"/> Rotary <input type="checkbox"/> Driven <input type="checkbox"/> Dug <input type="checkbox"/> Hollow rod <input type="checkbox"/> Jetted <input type="checkbox"/> Bored <input type="checkbox"/> Reverse rotary | | |
| 5. Type and color of material | | From | | To | | 8. Use: <input checked="" type="checkbox"/> Domestic <input type="checkbox"/> Public supply <input type="checkbox"/> Industry <input type="checkbox"/> Irrigation <input type="checkbox"/> Air conditioning <input type="checkbox"/> Stock <input type="checkbox"/> Lawn <input type="checkbox"/> Oil field water <input type="checkbox"/> Other |
| soil & clay | | 0 | | 15 | | 9. Casing: Material <input type="checkbox"/> Threaded <input type="checkbox"/> Welded <input type="checkbox"/> Surface 18 in. RMP <input type="checkbox"/> PVC <input type="checkbox"/> Weight sch 40 lbs./ft. Dia. 6 1/2 in. to 20 ft. depth Wall Thickness: inches or Dia. <input type="checkbox"/> in. to <input type="checkbox"/> ft. depth gauge No. sch 40 |
| gray shald | | 15 | | 98 | | 10. Screen: Manufacturer's name none Type <input type="checkbox"/> Dia. <input type="checkbox"/> Slot/gauze <input type="checkbox"/> Length <input type="checkbox"/> Set between <input type="checkbox"/> ft. and <input type="checkbox"/> ft. <input type="checkbox"/> ft. and <input type="checkbox"/> ft. |
| greyish sand | | 98 | | 102 | | Gravel pack? no Size range of material <input type="checkbox"/> |
| gray shald | | 102 | | 107 | | 11. Static water level: 70 ft. below land surface Date 11-22-78 mo./day/yr. |
| lime | | 107 | | 109 | | 12. Pumping level below land surfaces: ft. after <input type="checkbox"/> hrs. pumping <input type="checkbox"/> g.p.m. ft. after <input type="checkbox"/> hrs. pumping <input type="checkbox"/> g.p.m. Estimated maximum yield 30 g.p.m. |
| grey sand rock | | 109 | | 115 | | 13. Water sample submitted: <input type="checkbox"/> Yes <input checked="" type="checkbox"/> No Date <input type="checkbox"/> mo./day/yr. |
| gray shald | | 115 | | 120 | | 14. Well head completion: <input checked="" type="checkbox"/> Pitless adapter x 8" Pump House Inches above grade |
| white sand | | 120 | | 145 | | 15. Well grouted? <input type="checkbox"/> With: <input checked="" type="checkbox"/> Neat cement <input type="checkbox"/> Bentonite <input type="checkbox"/> Concrete Depth: From 0 ft. to 20 ft. |
| | | | | | | 16. Nearest source of possible contamination: ft. 100 Direction south Type septic Well disinfected upon completion? <input checked="" type="checkbox"/> Yes <input type="checkbox"/> No |
| | | | | | | 17. Pump: <input checked="" type="checkbox"/> Not installed Manufacturer's name <input type="checkbox"/> Model number <input type="checkbox"/> HP <input type="checkbox"/> Volts <input type="checkbox"/> Length of drop pipe <input type="checkbox"/> ft. capacity <input type="checkbox"/> g.p.m. Type: <input type="checkbox"/> Submersible <input type="checkbox"/> Turbine <input type="checkbox"/> Jet <input type="checkbox"/> Reciprocating <input type="checkbox"/> Centrifugal <input type="checkbox"/> Other |
| 18. Elevation: | | 19. Remarks: | | 20. Water well contractor's certification: This well was drilled under my jurisdiction and this report is true to the best of my knowledge and belief. Royce Swank Drilling 371 Business name License No. Address RR1 Ottawa Kan. Signed Royce Swank Date 11-22-78 Authorized representative | | |

Forward the white, blue and pink copies to the Department of Health and Environment

Form WWC-5