USE TYPEWRITER OR BALL POINT PEN-PRESS FIRMLY, PRINT CLEARLY.

WATER WELL RECORD
KSA 82a-1201-1215

Kansas Department of Health and Environment-Division of Environment
(Water well Contractors)
Topeka, Kansas 66620

1. Location of well:	County	Fraction	Section number	Township number	Range number
	Franklin	SW 1/4 SW 1/4 SW 1/4	32	T 16 (S)	R 18 E/W

2. Distance and direction from nearest town or city: IN TOWN
Street address of well location if in city: of Pamona

3. Owner of well: City of Pamona
R.R. or street:
City, state, zip code: Pamona, Kansas 66076

4. Locate with "X" in section below:

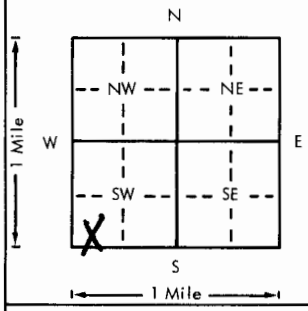

Sketch map:

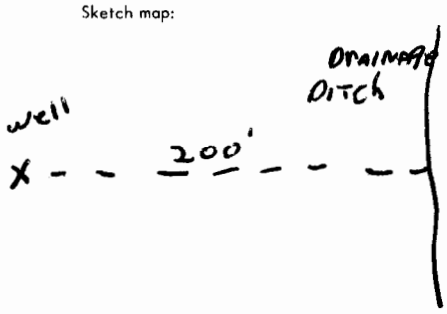

6. Bore hole dia. 12 in. Completion date 5-18-79
Well depth 208 ft.

7. __ Cable tool ✓ Rotary __ Driven __ Dug
__ Hollow rod __ Jetted __ Bored __ Reverse rotary

8. Use: __ Domestic ✓ Public supply __ Industry
__ Irrigation __ Air conditioning __ Stock
__ Lawn __ Oil field water __ Other

9. Casing: Material PVC Height (Above) or below
Threaded ___ Welded ___ Surface 48 in.
RMP ___ PVC ✓ Weight 4.62 lbs./ft.
Dia. [redacted] in. to [redacted] ft. depth Wall Thickness: inches or
Dia. 6 in. to 181 ft. depth gage No. -316

5. Type and color of material	From	To
Top soil	0	2
Clay, brown	2	7
Sandy shale	7	55
Sandstone	55	85
Sandy shale	85	90
Sandstone, water bearing	90	105
Sandy shale	105	110
Shaley Lime	110	121
Sandy shale	121	167
Sandstone water bearing	167	195
Sandy shale	195	208

(Use a second sheet if needed)

10. Screen: Manufacturer's name Pumpco MPI
Type PVC Dia. 6
Slot/gauze .060 Length 100
Set between 108 ft. and 208 ft.
___ ft. and ___ ft.
Gravel pack? ✓ Size range of material 1/4 x 1/8

11. Static water level: mo./day/yr.
80 ft. below land surface Date 5-18-79

12. Pumping level below land surfaces:
___ ft. after ___ hrs. pumping ___ g.p.m.
___ ft. after ___ hrs. pumping ___ g.p.m.
Estimated maximum yield 60 g.p.m.

13. Water sample submitted: mo./day/yr.
✓ Yes ___ No Date

14. Well head completion: CAP
___ Pitless adapter 48 Inches above grade

15. Well grouted? ✓
With: ✓ Neat cement ___ Bentonite ___ Concrete
Depth: From 0 ft. to 25 ft.

16. Nearest source of possible contamination:
ft. 200 Direction E Type Drainage
Well disinfected upon completion? ✓ Yes ___ No

17. Pump: ___ Not installed
Manufacturer's name Jensen
Model number 150W30 HP 5 Volts 230
Length of drop pipe 195 ft. capacity 20 g.p.m.
Type:
___ Submersible ___ Turbine
___ Jet ✓ Reciprocating
___ Centrifugal ___ Other

T 16 R 18 E/W Sec 1/4 1/4 1/4 SE SE SE

18. Elevation: 955
Topography:
✓ Hill
___ Slope
___ Upland
___ Valley

19. Remarks:
Slab installed - Bldg Floor
#9 Note
25' of 6" Steel .280 wall 19.1b pipe
set 0-23' on Top - (2' Above grd.)

20. Water well contractor's certification:
This well was drilled under my jurisdiction and this report is true to the best of my knowledge and belief.
Strader Drlg Co Inc 182
Business name License No.
Address RT 1 Holton, KS
Signed Dale Robin Date 5-22-79
Authorized representative

Forward the white, blue and pink copies to the Department of Health and Environment

Form WWC-5

MI-1023