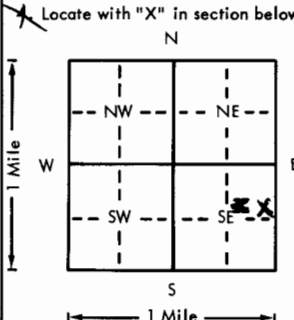
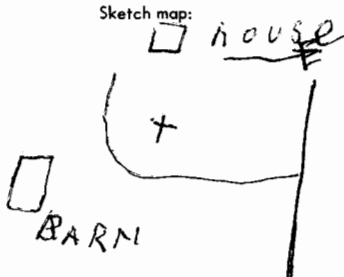


USE TYPEWRITER OR BALL POINT PEN—PRESS FIRMLY, PRINT CLEARLY.

WATER WELL RECORD
KSA 82a-1201-1215

Kansas Department of Health and Environment—Division of Environment (Water well Contractors) Topeka, Kansas 66620

<input checked="" type="checkbox"/> Location of well:	County Franklin	Section SE 1/4 N.E. 1/4 S.E. 1/4	Section number 33	Township number T 16 S R 18 E 4	Range number																								
2. Distance and direction from nearest town or city: 2 miles East, 1/2 mile North Street address of well location if in city: Pomona, Kansas			3. Owner of well: Mike Holmes R.R. or street: R.R. 1 City, state, zip code: Pomona, Kansas 66076																										
4. Locate with "X" in section below: 			Sketch map: 			6. Bore hole dia. 6 1/2 in. Completion date 5-11-78 Well depth 135 ft. 9" to 22'																							
5. Type and color of material <table border="1" style="width:100%; border-collapse: collapse;"> <thead> <tr> <th style="width:80%;"></th> <th style="width:10%;">From</th> <th style="width:10%;">To</th> </tr> </thead> <tbody> <tr> <td>Soil & Gravel</td> <td>0</td> <td>4</td> </tr> <tr> <td>Yellow Sand Rock (Water)</td> <td>4</td> <td>76</td> </tr> <tr> <td>Grey Sand</td> <td>76</td> <td>88</td> </tr> <tr> <td>Grey Sandy Shale</td> <td>88</td> <td>105</td> </tr> <tr> <td>Grey Sand</td> <td>105</td> <td>120</td> </tr> <tr> <td>Grey Shale</td> <td>120</td> <td>129</td> </tr> <tr> <td>White Sand (Water)</td> <td>129</td> <td>135</td> </tr> </tbody> </table>				From	To	Soil & Gravel	0	4	Yellow Sand Rock (Water)	4	76	Grey Sand	76	88	Grey Sandy Shale	88	105	Grey Sand	105	120	Grey Shale	120	129	White Sand (Water)	129	135	7. <input checked="" type="checkbox"/> Cable tool <input type="checkbox"/> Rotary <input type="checkbox"/> Driven <input type="checkbox"/> Dug <input type="checkbox"/> Hollow rod <input type="checkbox"/> Jetted <input type="checkbox"/> Bored <input type="checkbox"/> Reverse rotary		
				From	To																								
Soil & Gravel	0	4																											
Yellow Sand Rock (Water)	4	76																											
Grey Sand	76	88																											
Grey Sandy Shale	88	105																											
Grey Sand	105	120																											
Grey Shale	120	129																											
White Sand (Water)	129	135																											
8. Use: <input checked="" type="checkbox"/> Domestic <input type="checkbox"/> Public supply <input type="checkbox"/> Industry <input type="checkbox"/> Irrigation <input type="checkbox"/> Air conditioning <input type="checkbox"/> Stock <input type="checkbox"/> Lawn <input type="checkbox"/> Oil field water <input type="checkbox"/> Other			9. Casing: Material _____ Height: Above ground Threaded _____ Welded _____ Surface 12 in. RMP _____ PVC _____ Weight Sch 40 lbs./ft. Dia. 6 1/2 in. to 22' ft. depth Wall Thickness: inches or Dia. _____ in. to _____ ft. depth gage No. Sch 40																										
10. Screen: Manufacturer's name _____ NONE Type _____ Dia. _____ Slot/gauze _____ Length _____ Set between _____ ft. and _____ ft. _____ ft. and _____ ft. Gravel pack? _____ Size range of material _____			11. Static water level: _____ mo./day/yr. 100 ft. below land surface Date 5-11-78																										
12. Pumping level below land surfaces: _____ ft. after _____ hrs. pumping _____ g.p.m. _____ ft. after _____ hrs. pumping _____ g.p.m. Estimated maximum yield 30 g.p.m.			13. Water sample submitted: _____ mo./day/yr. Yes <input checked="" type="checkbox"/> No <input type="checkbox"/> Date _____																										
14. Well head completion: <input type="checkbox"/> Pitless adapter PUMP HOUSE inches above grade			15. Well grouted? <input checked="" type="checkbox"/> With: <input checked="" type="checkbox"/> Neat cement <input type="checkbox"/> Bentonite <input type="checkbox"/> Concrete Depth: From 0 ft. to 22' ft.																										
16. Nearest source of possible contamination: 100 Direction north Type Septic Well disinfected upon completion? <input checked="" type="checkbox"/> Yes <input type="checkbox"/> No			17. Pump: _____ Not installed Manufacturer's name Red Jacket Model number 150N1 HP 1/2 Volts 220 Length of drop pipe 125 ft. capacity 10 g.p.m. Type: <input checked="" type="checkbox"/> Submersible <input type="checkbox"/> Turbine <input type="checkbox"/> Jet <input type="checkbox"/> Reciprocating <input type="checkbox"/> Centrifugal <input type="checkbox"/> Other																										
18. Elevation: Topography: <input type="checkbox"/> Hill <input type="checkbox"/> Slope <input checked="" type="checkbox"/> Upland <input type="checkbox"/> Valley			19. Remarks: This well was Drilled before the Septic tank was put in																										
(Use a second sheet if needed)			20. Water well contractor's certification: This well was drilled under my jurisdiction and this report is true to the best of my knowledge and belief. Edgar Swank Drilling 124 Business name _____ License No. _____ Address R.R. 1 Ottawa, Kansas Signed Edgar Swank Date 8-20-78 Authorized representative																										

T
R
W
Sec
1/4
1/4
1/4
SE NESE

Forward the white, blue and pink copies to the Department of Health and Environment

Form WWC-5