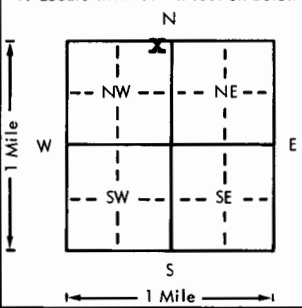


USE TYPEWRITER OR BALL POINT PEN-PRESS FIRMLY, PRINT CLEARLY.

WATER WELL RECORD
KSA 82a-1201-1215

Kansas Department of Health and Environment-Division of Environment (Water well Contractors) Topeka, Kansas 66620

1. Location of well:		County Franklin	Fraction N.E. 1/4 N.E. 1/4 N.W. 1/4	Section number 33	Township number T 16 S R 18 E 4	Range number
2. Distance and direction from nearest town or city: 1 Mi N. 1 Mi E. Street address of well location if in city: POMONA			3. Owner of well: Orvil Hull R.R. or street: R.R. City, state, zip code: Pomona, Kansas 66046			
4. Locate with "X" in section below: 			Sketch map: Country Road House SEPTIC			6. Bore hole dia. 6 1/4 in. Completion date 8-12-77 Well depth 125 ft. 8" to 20'
5. Type and color of material			From	To	7. <input checked="" type="checkbox"/> Cable tool <input type="checkbox"/> Rotary <input type="checkbox"/> Driven <input type="checkbox"/> Dug <input type="checkbox"/> Hollow rod <input type="checkbox"/> Jetted <input type="checkbox"/> Bored <input type="checkbox"/> Reverse rotary	
Soil			0	4	8. Use: <input checked="" type="checkbox"/> Domestic <input type="checkbox"/> Public supply <input type="checkbox"/> Industry <input type="checkbox"/> Irrigation <input type="checkbox"/> Air conditioning <input type="checkbox"/> Stock <input type="checkbox"/> Lawn <input type="checkbox"/> Oil field water <input type="checkbox"/> Other	
Yellow Sand & Rock			4	50	9. Casing: Material _____ Height: Above XXXX Threaded _____ Welded _____ Surface 18 in. RMP _____ PVC _____ Weight Sch 40 lbs./ft. Dia. 6 in. to 21 ft. depth Wall Thickness: inches or Dia. _____ in. to _____ ft. depth gage No. Sch 40	
Grey Sand			50	121	10. Screen: Manufacturer's name _____ NONE Type _____ Dia. _____ Slot/gauze _____ Length _____ Set between _____ ft. and _____ ft. _____ ft. and _____ ft. Gravel pack? _____ Size range of material _____	
White Sand			121	125	11. Static water level: _____ mo./day/yr. 25 ft. below land surface Date 8-12-77	
					12. Pumping level below land surfaces: _____ ft. after _____ hrs. pumping _____ g.p.m. _____ ft. after _____ hrs. pumping _____ g.p.m. Estimated maximum yield 30 g.p.m.	
					13. Water sample submitted: _____ mo./day/yr. Yes <input checked="" type="checkbox"/> No <input type="checkbox"/> Date _____	
					14. Well head completion: <input checked="" type="checkbox"/> Pitless adapter 18 inches above grade	
					15. Well grouted? <input checked="" type="checkbox"/> With <input checked="" type="checkbox"/> Neat cement <input type="checkbox"/> Bentonite <input type="checkbox"/> Concrete Depth: From 3 ft. to 20 ft.	
					16. Nearest source of possible contamination: ft. 15 Direction Southwest Type Septic Well disinfected upon completion? <input checked="" type="checkbox"/> Yes <input type="checkbox"/> No	
					17. Pump: <input checked="" type="checkbox"/> Not installed Manufacturer's name _____ Model number _____ HP _____ Volts _____ Length of drop pipe _____ ft. capacity _____ g.p.m. Type: <input type="checkbox"/> Submersible <input type="checkbox"/> Turbine <input type="checkbox"/> Jet <input type="checkbox"/> Reciprocating <input type="checkbox"/> Centrifugal <input type="checkbox"/> Other	
(Use a second sheet if needed)						
18. Elevation: Topography: <input type="checkbox"/> Hill <input type="checkbox"/> Slope <input checked="" type="checkbox"/> Upland <input type="checkbox"/> Valley		19. Remarks: The customer is going pour own cement and put his own pump in.			20. Water well contractor's certification: This well was drilled under my jurisdiction and this report is true to the best of my knowledge and belief. Edgar Swank Drilling 124A Business name License No. _____ Address R.R. #4 Ottawa, Kansas Signed Edgar Swank Date Oct. 2, 77 Authorized representative	

T 16 S R 18 E 4
Sec 33
1/4 1/4 1/4