


WATER WELL RECORD Form WWC-5 KSA 82a-1212

1 LOCATION OF WATER WELL: County: Franklin Fraction: SW 1/4 SE 1/4 SE 1/4 Section Number: 34 Township Number: T 16 S Range Number: R 18 E

Distance and direction from nearest town or city street address of well if located within city?
2 1/2 east Pomona

2 WATER WELL OWNER: Warren Baskettt
 RR#, St. Address, Box #: Pomona Kan 66096
 City, State, ZIP Code: Pomona Kan 66096
 Board of Agriculture, Division of Water Resources
 Application Number:

3 LOCATE WELL'S LOCATION WITH AN "X" IN SECTION BOX:

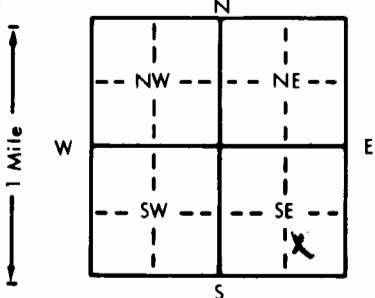

4 DEPTH OF COMPLETED WELL: 80 ft. ELEVATION:

Depth(s) Groundwater Encountered: 1 28 30 ft. 2. 80 ft. 3. July 26, 82 ft.
 WELL'S STATIC WATER LEVEL: 28 30 ft. below land surface measured on mo/day/yr
 Pump test data: Well water was 18 ft. after 8 1/4 hours pumping 30 gpm
 Est. Yield: 18 gpm; Well water was 6 1/4 ft. after 80 hours pumping
 Bore Hole Diameter: 8 1/4 in. to 30 ft., and 6 1/4 in. to 80 ft.
 WELL WATER TO BE USED AS:
 Domestic 3 Feedlot 6 Oil field water supply 9 Dewatering 12 Other (Specify below)
 2 Irrigation 4 Industrial 7 Lawn and garden only 10 Observation well
 Was a chemical/bacteriological sample submitted to Department? Yes X No X; If yes, mo/day/yr sample was submitted
 Water Well Disinfected? Yes X No X

5 TYPE OF BLANK CASING USED:
 1 Steel 3 RMP (SR) 5 Wrought iron 8 Concrete tile CASING JOINTS: Glued Clamped
 2 PVC 4 ABS 6 Asbestos-Cement 9 Other (specify below) Welded
 7 Fiberglass Threaded

Blank casing diameter: 6 1/4 in. to 24 30 ft., Dia. Sch 40 in. to Sch 40 ft.
 Casing height above land surface: 24 30 in., weight Sch 40 lbs./ft. Wall thickness or gauge No. Sch 40

TYPE OF SCREEN OR PERFORATION MATERIAL:
 1 Steel 3 Stainless steel 5 Fiberglass 8 RMP (SR) 10 Asbestos-cement
 2 Brass 4 Galvanized steel 6 Concrete tile 9 ABS 12 None used (open hole)
 11 Other (specify)

SCREEN OR PERFORATION OPENINGS ARE:
 1 Continuous slot 3 Mill slot 5 Gauzed wrapped 8 Saw cut 11 None (open hole)
 2 Louvered shutter 4 Key punched 6 Wire wrapped 9 Drilled holes
 7 Torch cut 10 Other (specify)

SCREEN-PERFORATED INTERVALS: From NONE ft. to NONE ft., From NONE ft. to NONE ft.
 GRAVEL PACK INTERVALS: From NONE ft. to NONE ft., From NONE ft. to NONE ft.

6 GROUT MATERIAL: Neat cement 2 Cement grout 3 Bentonite 4 Other
 Grout Intervals: From 3 ft. to 30 ft., From 30 ft. to 80 ft., From 80 ft. to 80 ft.

What is the nearest source of possible contamination:
 1 Septic tank 4 Lateral lines 7 Pit privy 10 Livestock pens 14 Abandoned water well
 2 Sewer lines 5 Cess pool 8 Sewage lagoon 11 Fuel storage 15 Oil well/Gas well
 3 Watertight sewer lines 6 Seepage pit 9 Feedyard 12 Fertilizer storage 16 Other (specify below)
 13 Insecticide storage

Direction from well? East How many feet? 100

FROM	TO	LITHOLOGIC LOG	FROM	TO	LITHOLOGIC LOG
0	10	Soil			
10	30	yellow sand			
30	30	Rock			
30	30	grey sand			
31	80	white sand			

7 CONTRACTOR'S OR LANDOWNER'S CERTIFICATION: This water well was (1) constructed (2) reconstructed, or (3) plugged under my jurisdiction and was completed on (mo/day/year) July 26, 82 and this record is true to the best of my knowledge and belief. Kansas Water Well Contractor's License No. 391 This Water Well Record was completed on (mo/day/yr) SEP 83 under the business name of Royce Swank by (signature) Royce Swank

INSTRUCTIONS: Use typewriter or ball point pen, PLEASE PRESS FIRMLY and PRINT clearly. Please fill in blanks, underline or circle the correct answers. Send top three copies to Kansas Department of Health and Environment, Division of Environment, Environmental Geology Section, Topeka, KS 66620. Send one to WATER WELL OWNER and retain one for your records.